


T.35S. R.12E. W.M.

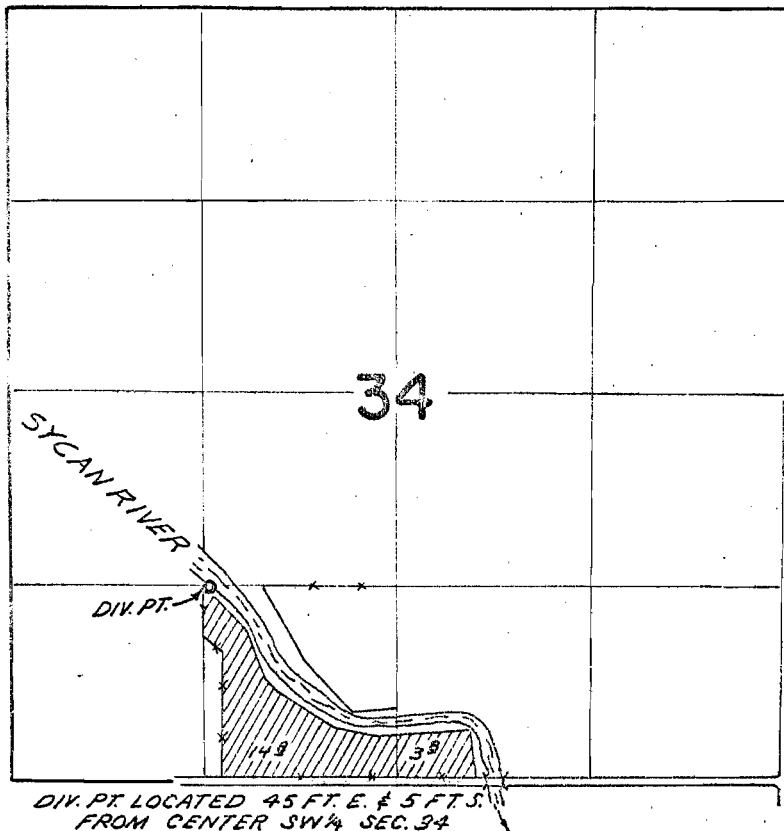

FINAL PROOF SURVEY
UNDER

Application No. 39916 Permit No. 29710
IN NAME OF

John & Lillian Mills

Surveyed Oct. 20, 1965, by W.J. Ruppert

35-12 ✓