


T.18 S. R.2W. W.M.

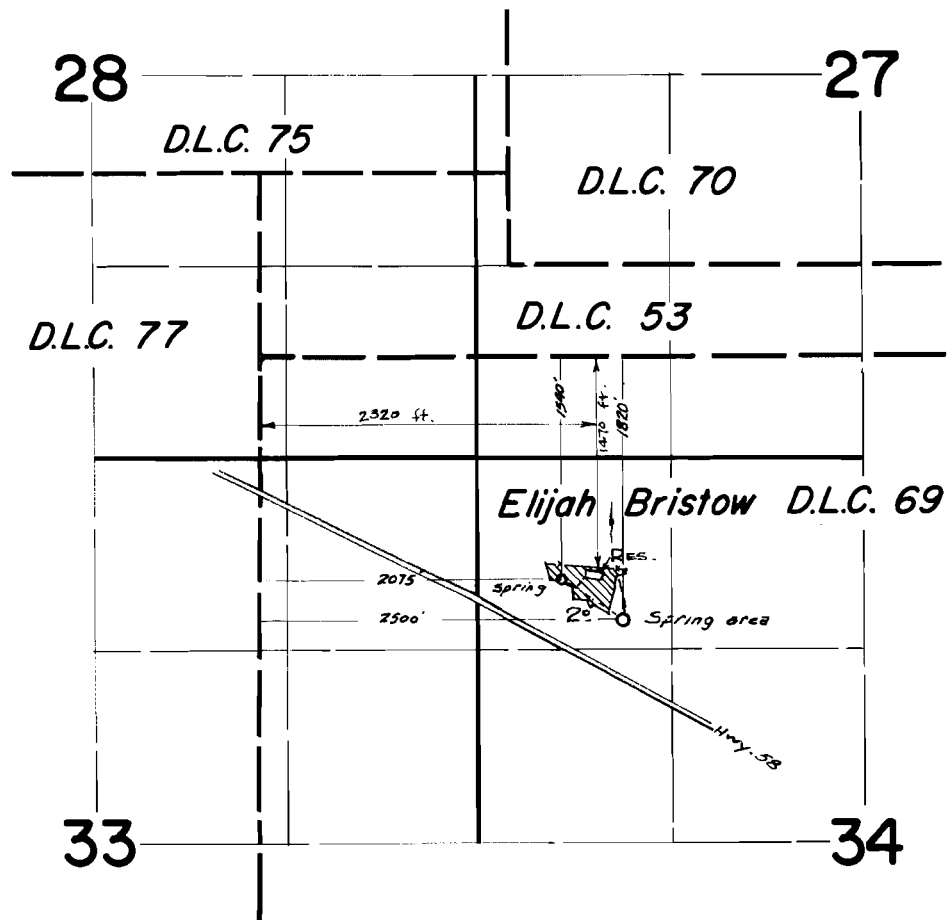

FINAL PROOF SURVEY
UNDER

R-35116 R-2643
Application No. 35117 Permit No. 27488
IN NAME OF

ADRIAN M. MASENGIL

Surveyed May 6, 1965, by *R. Jackson*
MAY 10, 1966, BY V. EARNER