


T.16 S. R.2 W. W.M.

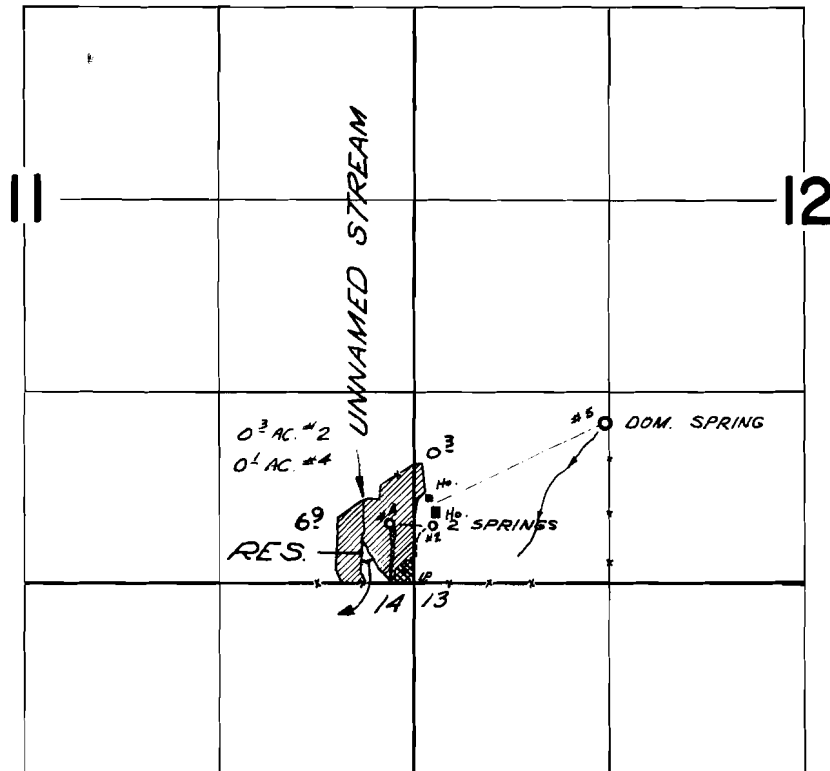

Spring #2 located 400 ft N. & 130 ft E. from the SW. cor. sec. 12
 Spring #4 located 420 ft N. & 160 ft W. from the SE. cor. Sec. 11
 Dom. Spring #5 located 1100 ft N. & 1320 ft E. from the SW. cor. Sec 12
 Stream div. pt. located 150 ft N & 310 ft W. from the SE. cor Sec 11

FINAL PROOF SURVEY UNDER

R 37929 R 3139
 Application No. 37930 Permit No. 28294
 IN NAME OF

DAN A. TEEL

Surveyed May 3, 1966, by V. GARNER