


T. 19S. R. 12W. W.M.

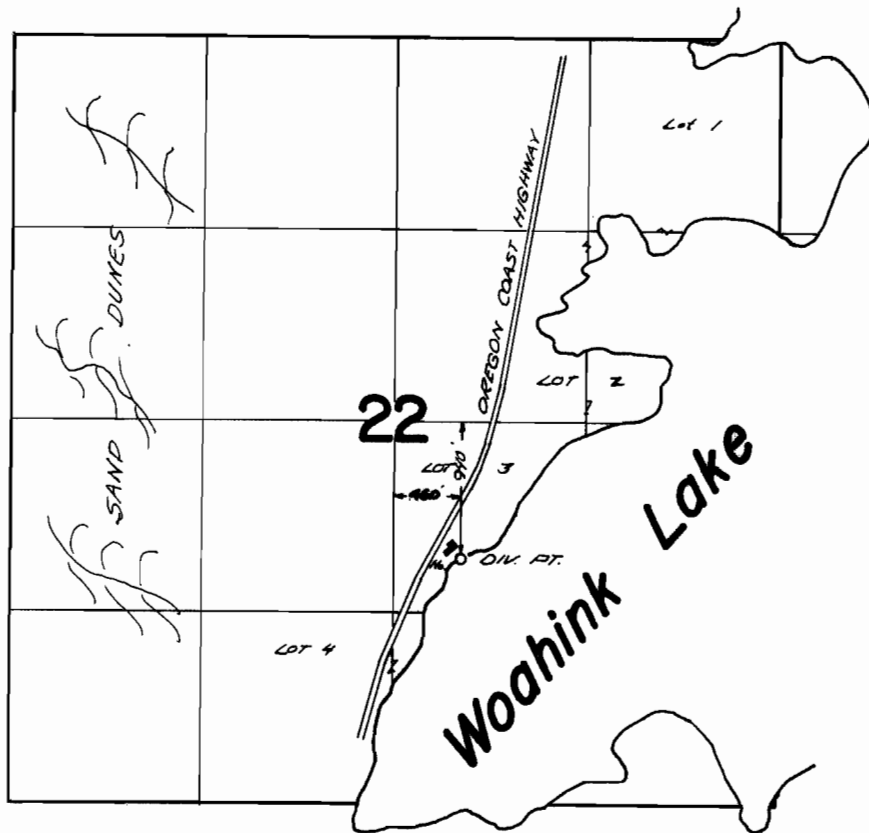

**FINAL PROOF SURVEY**  
UNDER

Application No. 39237 Permit No. 29236  
IN NAME OF

PHILIP D. HIMMEL

Surveyed July 13, 1967, by V. Garner