
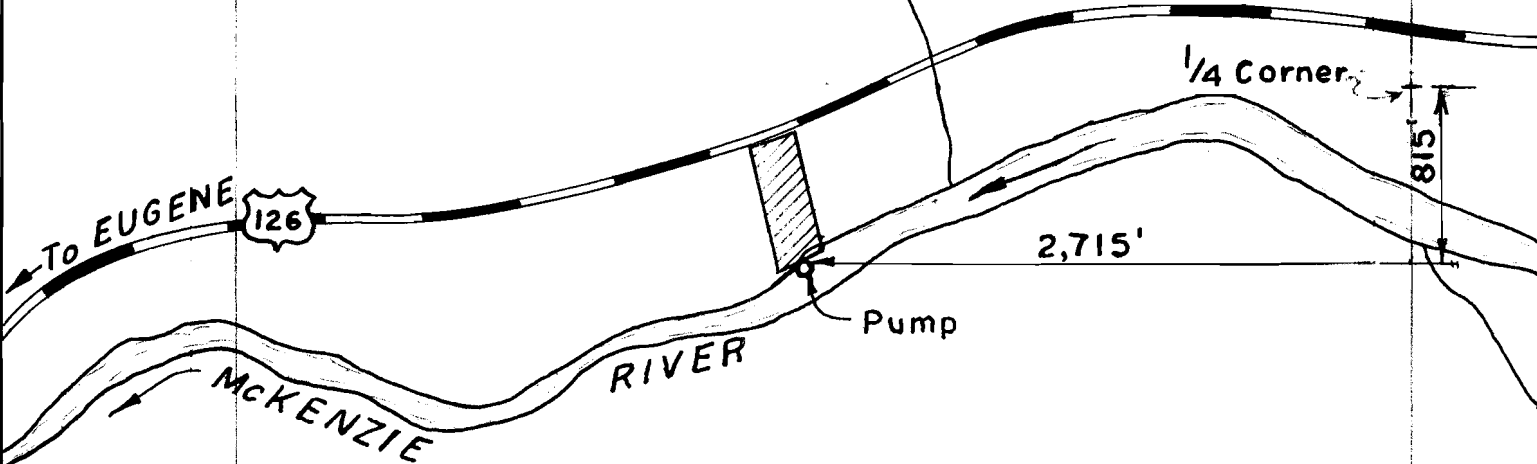


16

SEC. 15, R. 5 E., T. 16 S.

FLORENCE CREEK

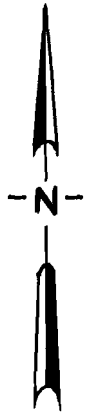

21

22

W. H. D. Parley

Application No. 40493

Permit No. 30333

WATER SUPPLY DEVELOPMENT

DONALD LYNAM PROPERTY
LANE COUNTY, OREGON

SCALE: 1" = 868'

RECEIVED
 STATE ENGINEER
 OREGON