


T. 16 S. R. 5 E. W. M.

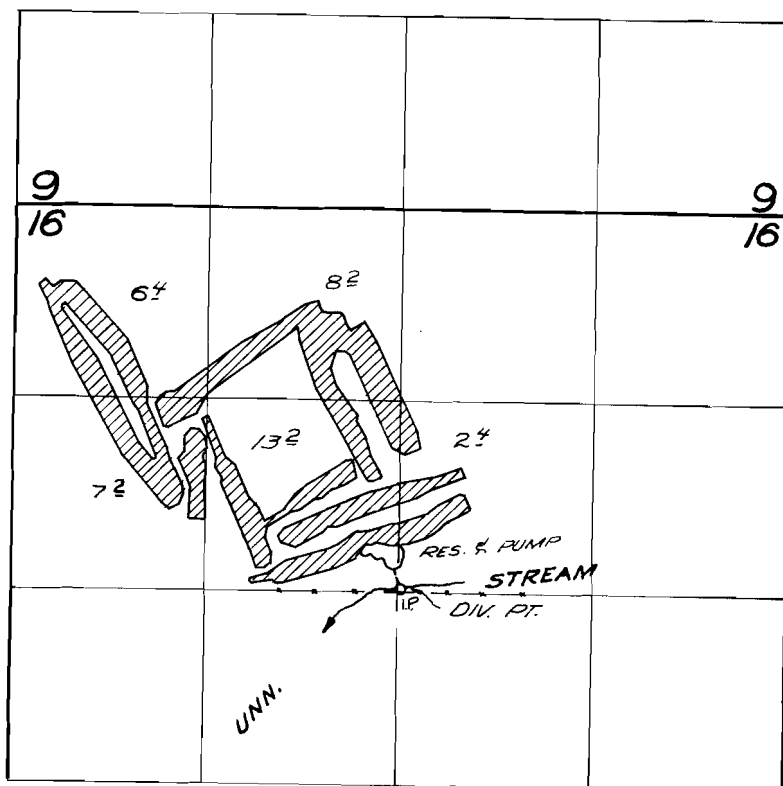

*Div. pt. located 20 ft. N. and 20 ft. E. from
the center of Section 16*

FINAL PROOF SURVEY
UNDER

R 41414 *R-4637*
Application No. *41415* Permit No. *30744*
IN NAME OF

N.B. GILISTINA

Surveyed *June 14 1967*, by *V. Garner*