


T. 16 S. R. 5 E. W. M.

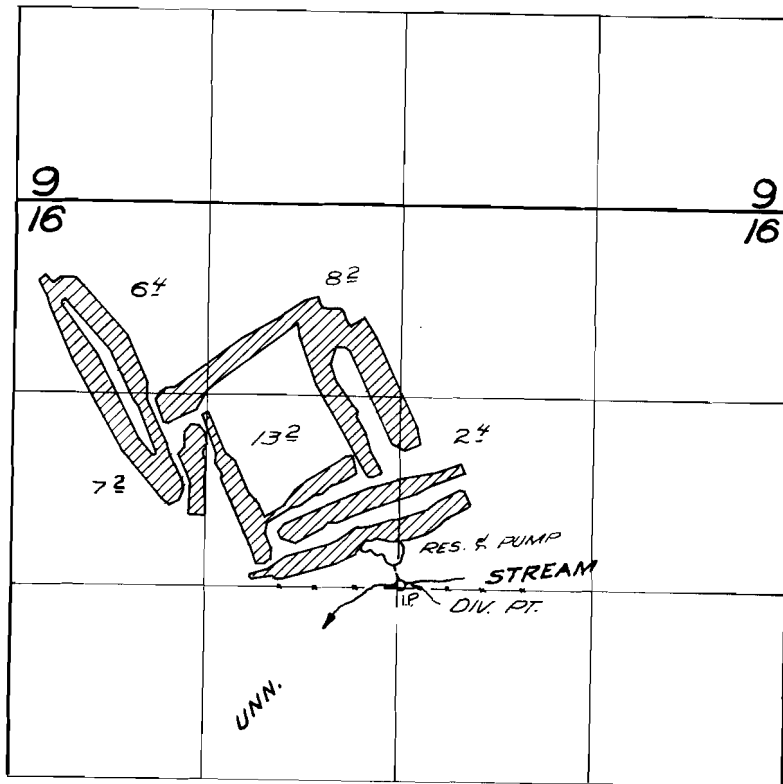

Div. pt. located 20 ft. N. and 20 ft. E. from
the center of Section 16

FINAL PROOF SURVEY
UNDER

R 41414 R-4637
Application No. 41415 Permit No. 30744
IN NAME OF

N. B. GILISTINA

Surveyed June 14, 1967, by V. Garner