


T.11S.R.2W.W.M.

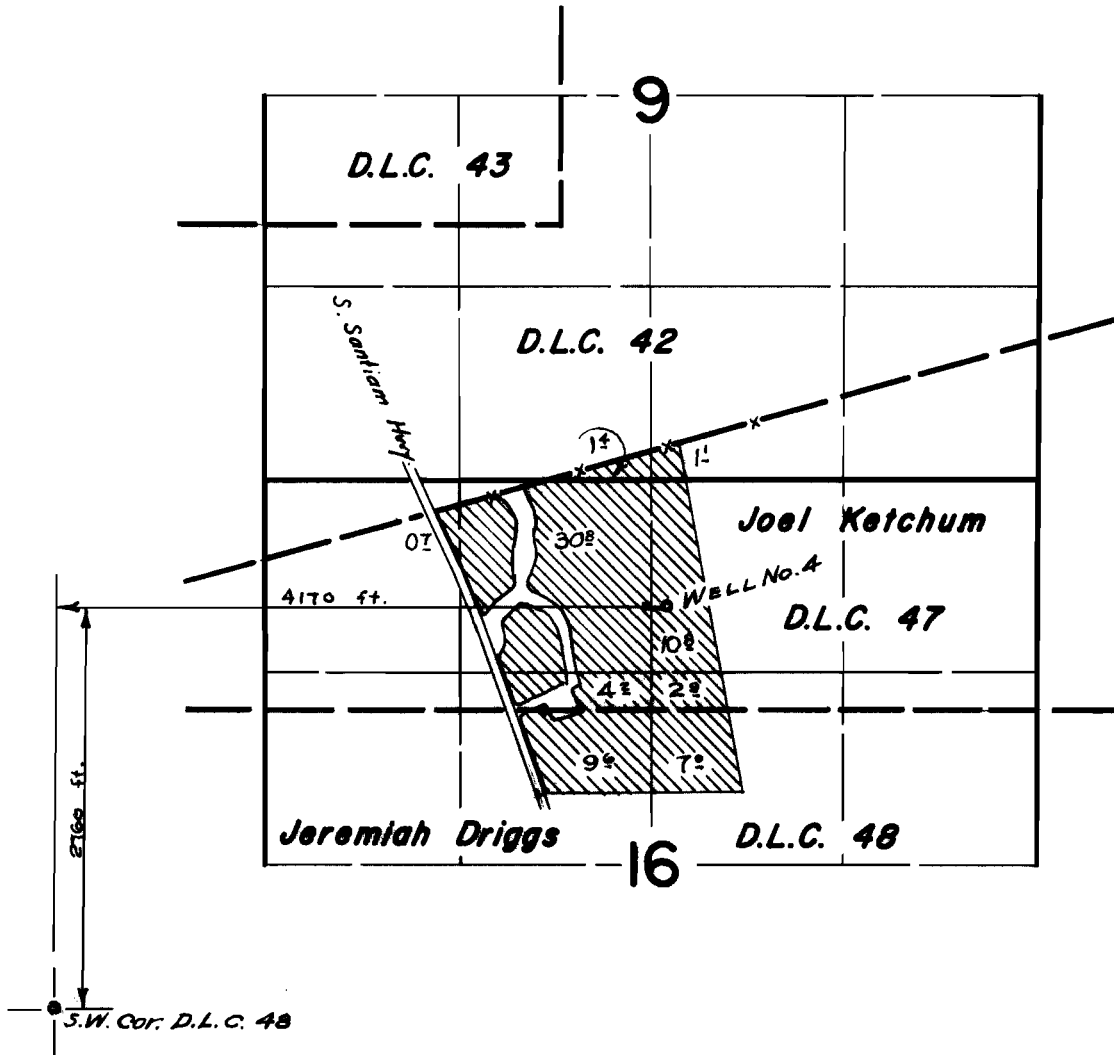

FINAL PROOF SURVEY
UNDER

Application No. ~~G-1557~~ Permit No. ~~G-1428~~
IN NAME OF

WEBBER DOUGHTON

Surveyed Nov. 16, 1964, by Floyd L. Siegmund
April 6, 1966 by R. H. Jackson