


T.18S.R.47E.W.M.

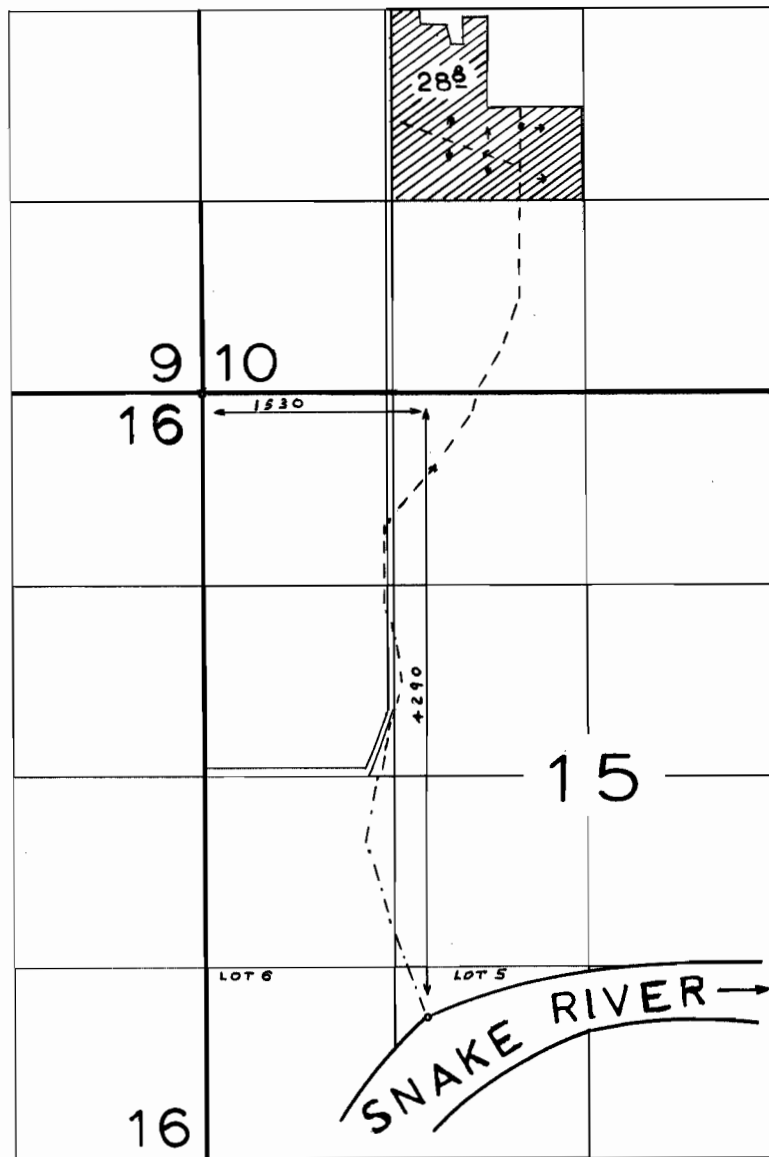

FINAL PROOF SURVEY
UNDER

Application No. 37003 Permit No. 27643

IN NAME OF

CARL McDROE

Surveyed MARCH 9 1966, by F. ELFERING