


T.6S. R.2W.W.M.

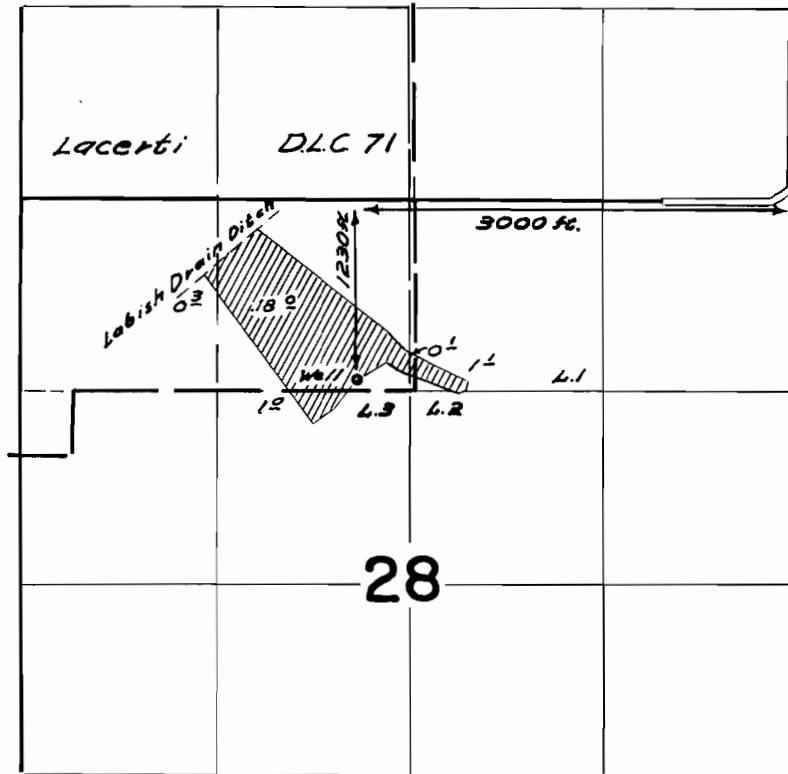

FINAL PROOF SURVEY
UNDER

Application No. G-2445 Permit No. G-2247
IN NAME OF

A. J. Oglesby

Surveyed Aug 18 1966, by W. d. Ruppert