


# T.7&8S. R.2W. W.M.

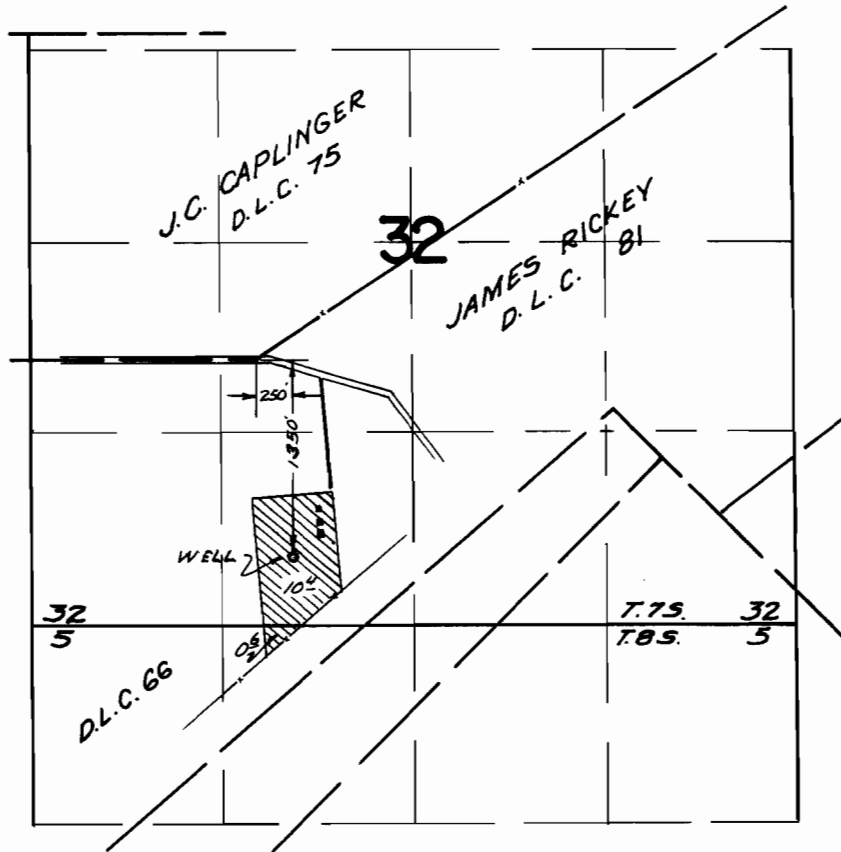

## FINAL PROOF SURVEY UNDER

Application No. G-3300 Permit No. G-3076  
IN NAME OF

FAY GOOCH

Surveyed Nov. 21, 1967, by V. Garner