


0 15

Range 11-15

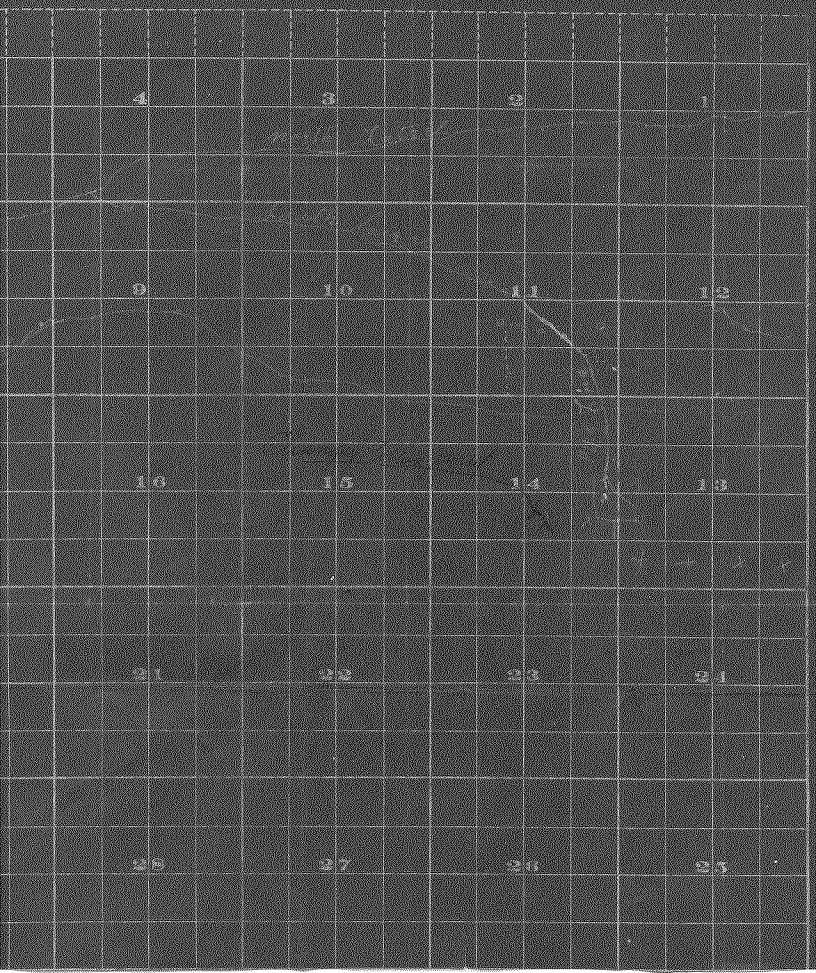

Township 5

Range

0

5

4

3

*1000 1000*

7

8

9

10

18

17

16

15

19

20

21

22

30

29

28

27