


T.8S. R.6W. W.M

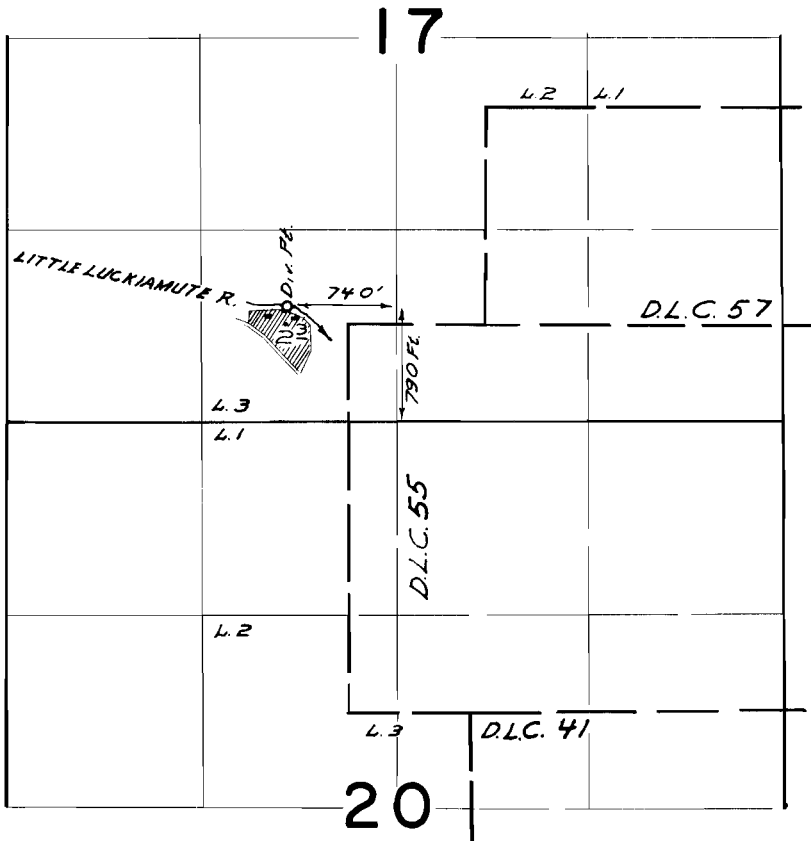

FINAL PROOF SURVEY

UNDER

Application No. 37683 Permit No. 28085
IN NAME OF

LE ROY A. MEYER

Surveyed April 27 1966, by W. J. Ruppert