


T.2S. R.39E. W.M.

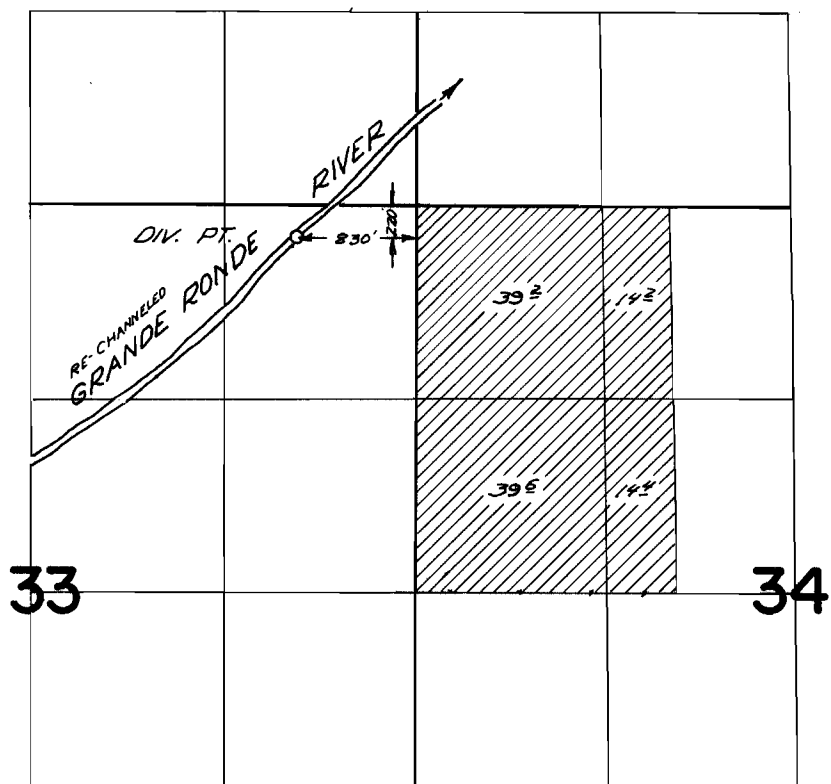

FINAL PROOF SURVEY
UNDER

Application No. 38294 Permit No. 28525
IN NAME OF

ALMA TRASK

Surveyed Aug. 24, 1967, by V. Garner