


T.3S.R.39E.W.M.

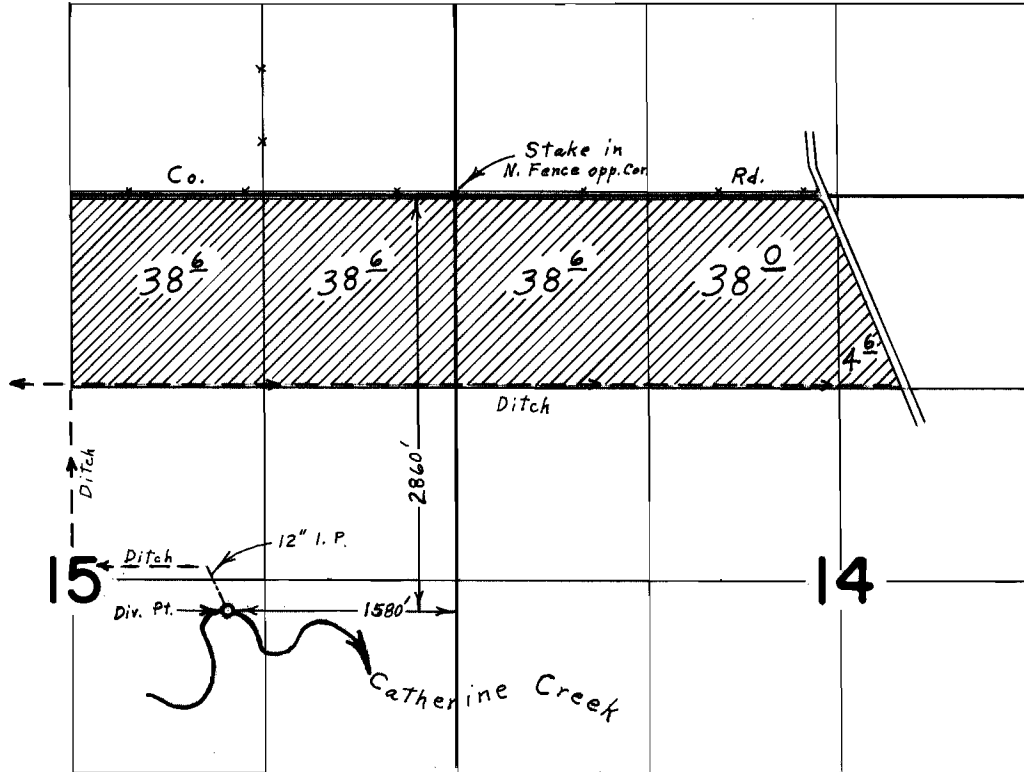

FINAL PROOF SURVEY
UNDER

Application No. 39043... Permit No. 29076...
IN NAME OF

RICHARD R. FULLER

Surveyed Nov. 2... 1966., by L. E. Gould...