


T. 3S. R. 38 & 39E.W.M.

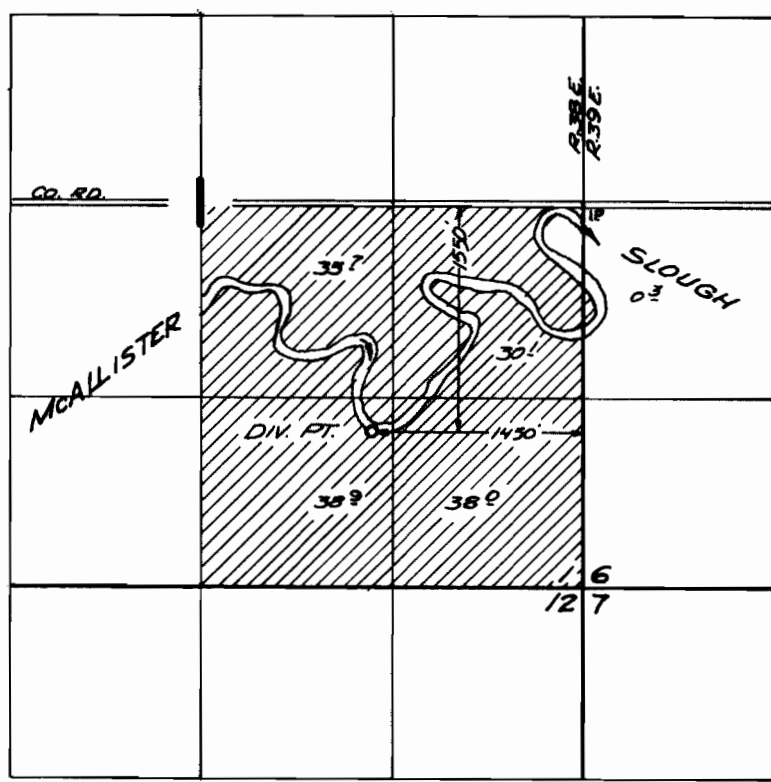

FINAL PROOF SURVEY UNDER

Application No. 10332 Permit No. 30277
IN NAME OF

JOSEPH HARRISON and WILMA HARRISON

Surveyed Aug. 29, 1967, by V. Garner