


T.2S. R.38E. W.M.

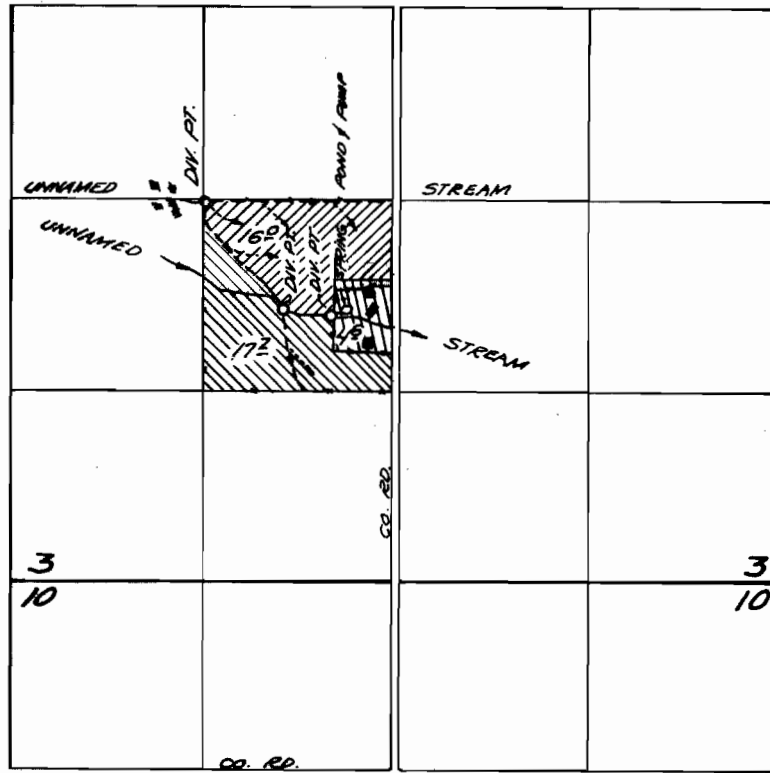


Div. pts. located:- northerly stream, 20 ft. S. & 1310 ft. W.,
southerly stream, 750 ft. S. & 770 ft. W., 800 ft. S. & 450 ft. W.,
Spring, 750 ft. S. & 340 ft. W., all from the center of section 3



North stream



South Stream

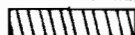

Spring

FINAL PROOF SURVEY UNDER

Application No. 42520... Permit No. 31943...
IN NAME OF

LEAL GRAHAM

Surveyed Aug. 31, 1967, by V. GARNER