


T.3S. R.45E.W.M.

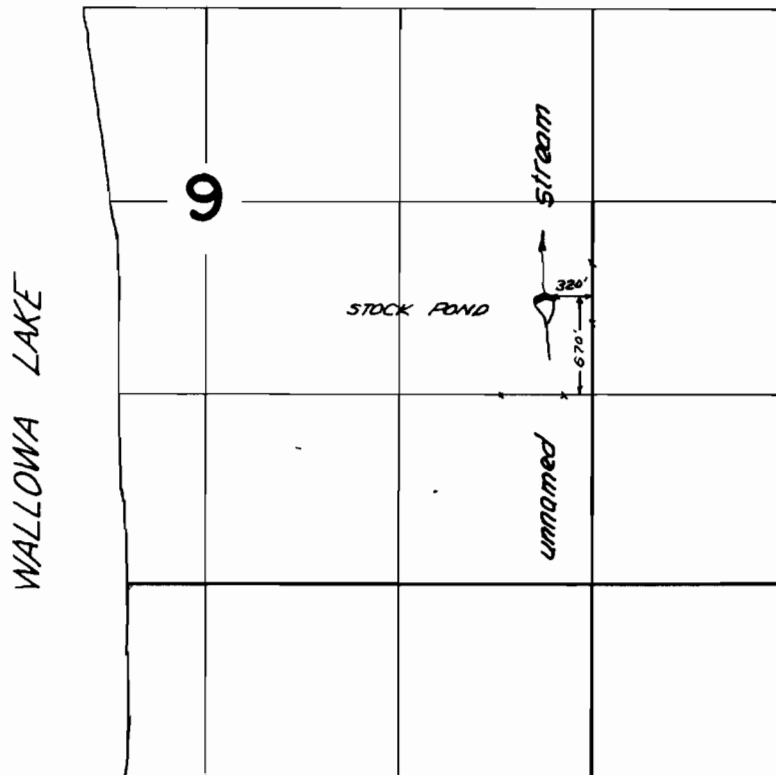

FINAL PROOF SURVEY UNDER

R 27261 *R 1347*
Application No. *27262*... Permit No. *21226*
IN NAME OF

Mrs. HATTIE BEAUDAIN

Surveyed *Oct. 7*... 1967, by *V. Garner*