


# T.3S. R.45E.W.M.

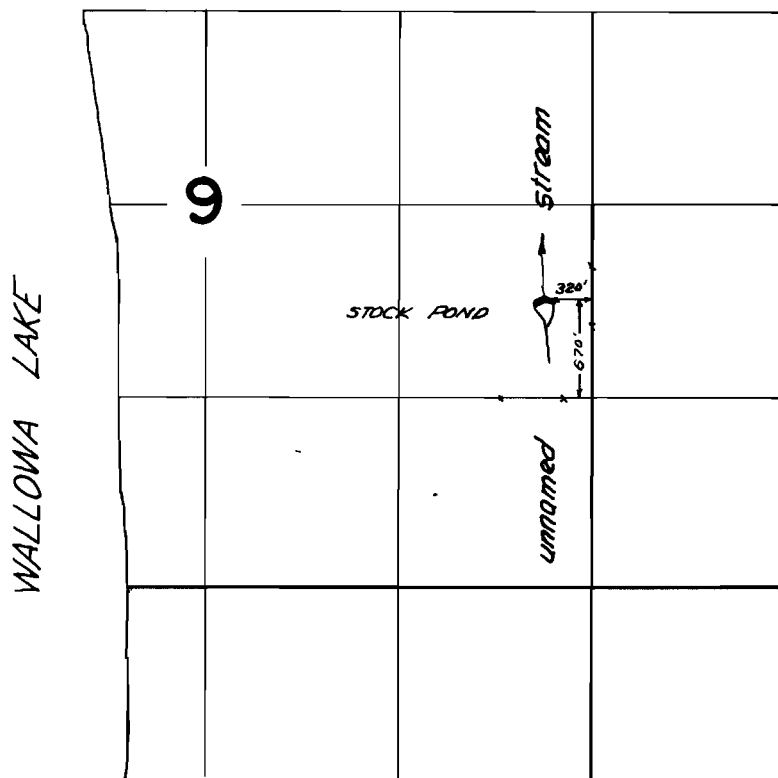

## FINAL PROOF SURVEY UNDER

Application No. *R 27261* *R 1347* Permit No. *27262* *21226*  
IN NAME OF

*Mrs. HATTIE BEAUDAIN*

Surveyed *Oct. 7* 1967, by *V. Garner*