


T.2S R.44E.W.M.

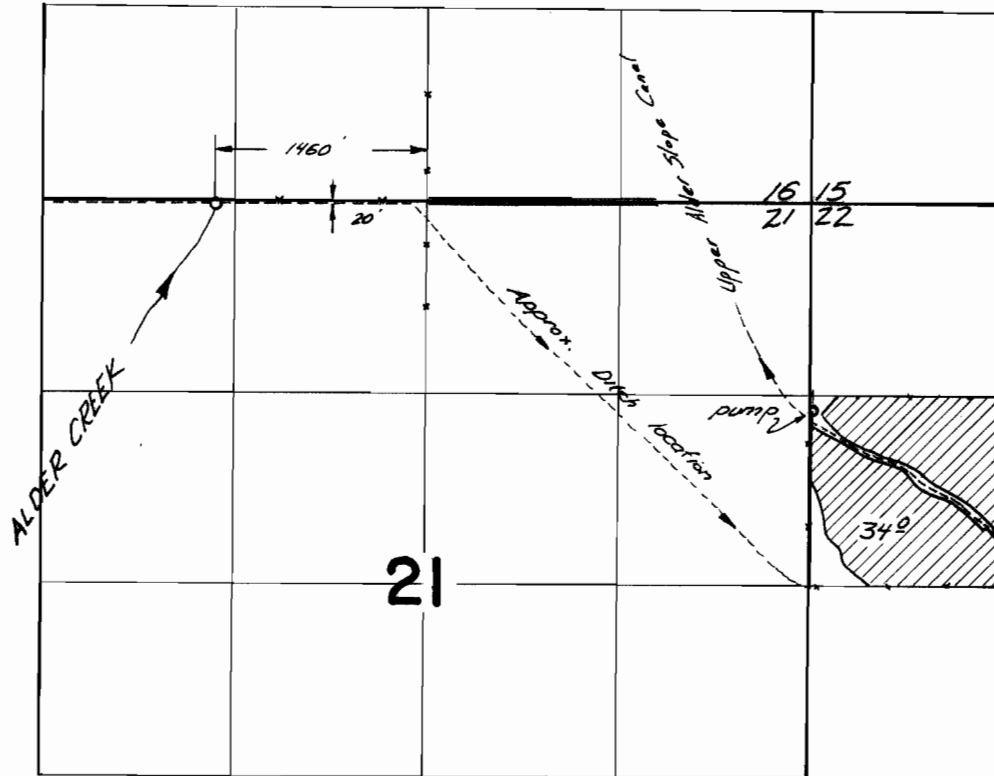

FINAL PROOF SURVEY UNDER

Application No. 38837 Permit No. 28892
IN NAME OF

OSCAR C. SHAFER

Surveyed Oct. 4, 1967, by V. Garner