


# T.1N. R.43E.W.M.

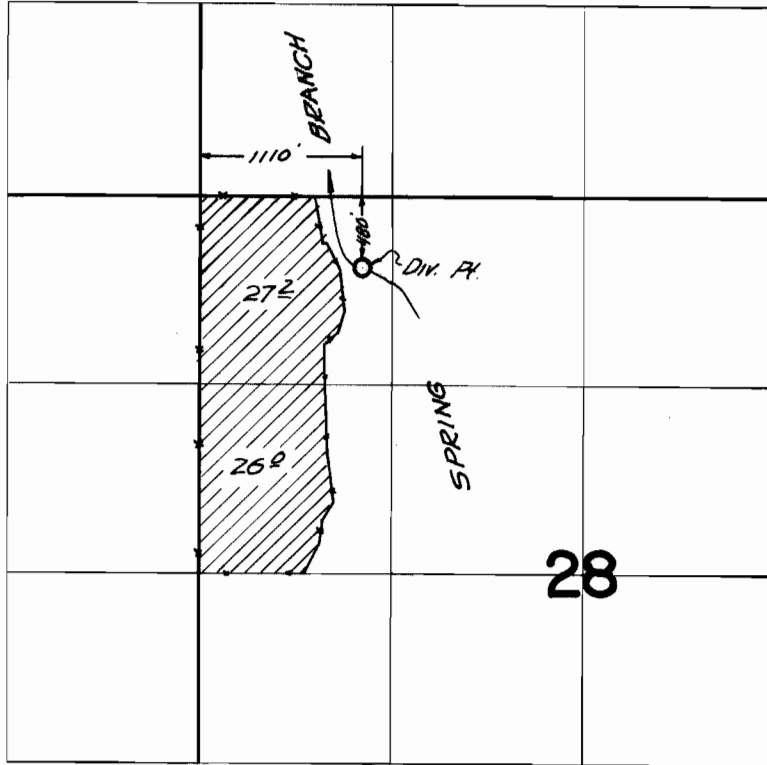

## FINAL PROOF SURVEY UNDER

Application No. 38886 Permit No. 29026  
IN NAME OF

G. L. KENVILLE

Surveyed Oct. 5 1967, by V. Gardner