


T. 48 & 5 S. R. 14 E. W. M.

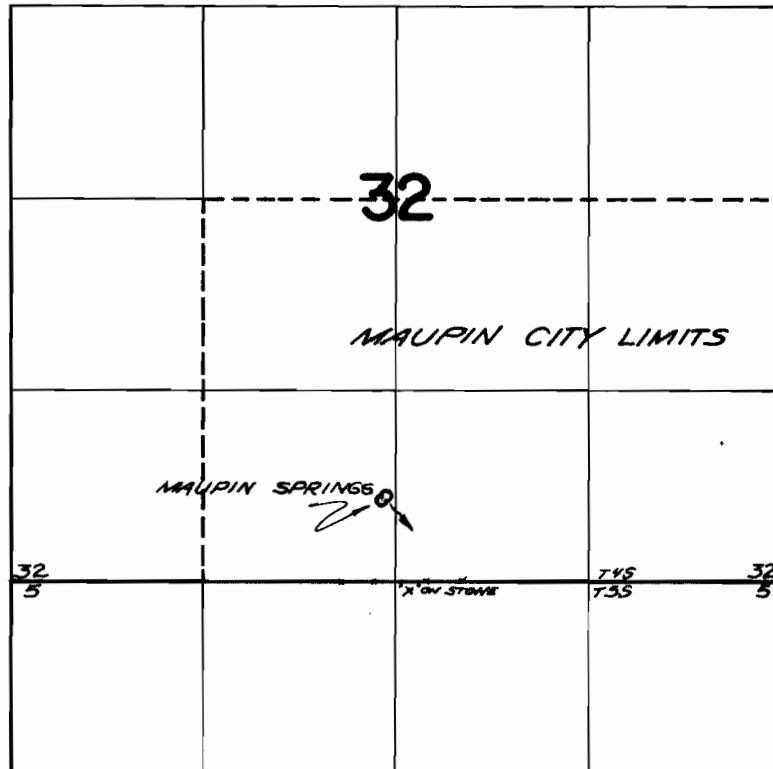

Springs located :- 580 ft. N. and 70 ft. W., 550 ft. N. and 90 ft. W., both from the S & W cor. Section 32

FINAL PROOF SURVEY
UNDER

Application No. 23545 Permit No. 12591
IN NAME OF

CITY OF MAUPIN

Surveyed Nov. 10 1967, by V. Gerner