


29816

T.4S.R.13E.W.M.

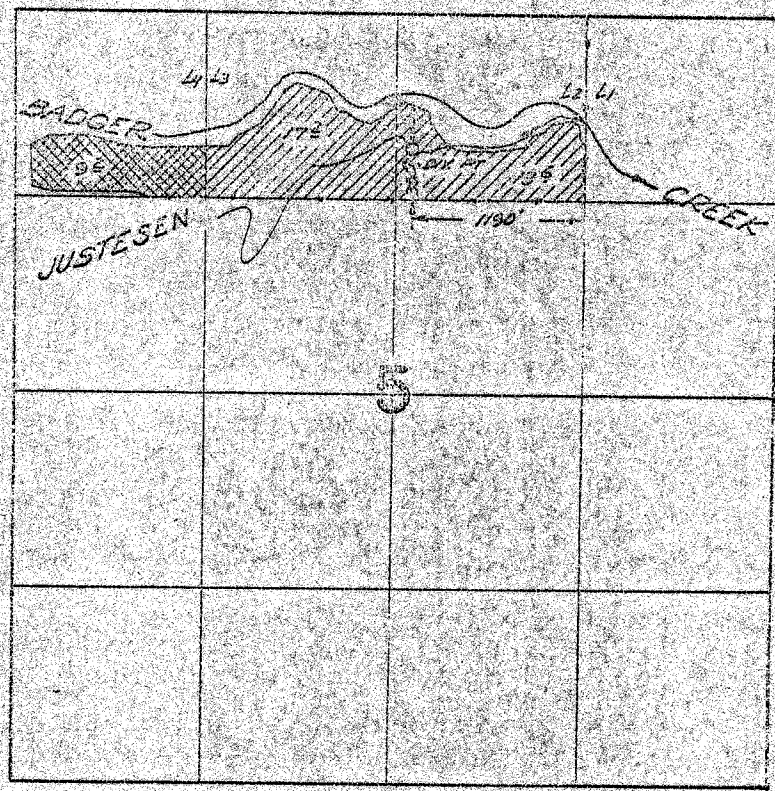

Primary
 Supplemental

FINAL PROOF SURVEY UNDER

Application No. 40089 Permit No. 29816
IN NAME OF

THEODORE and NELL JUSTESEN

Surveyed Nov. 17, 1967, by L. Garner