


# T.5S. R.13E. W.M.

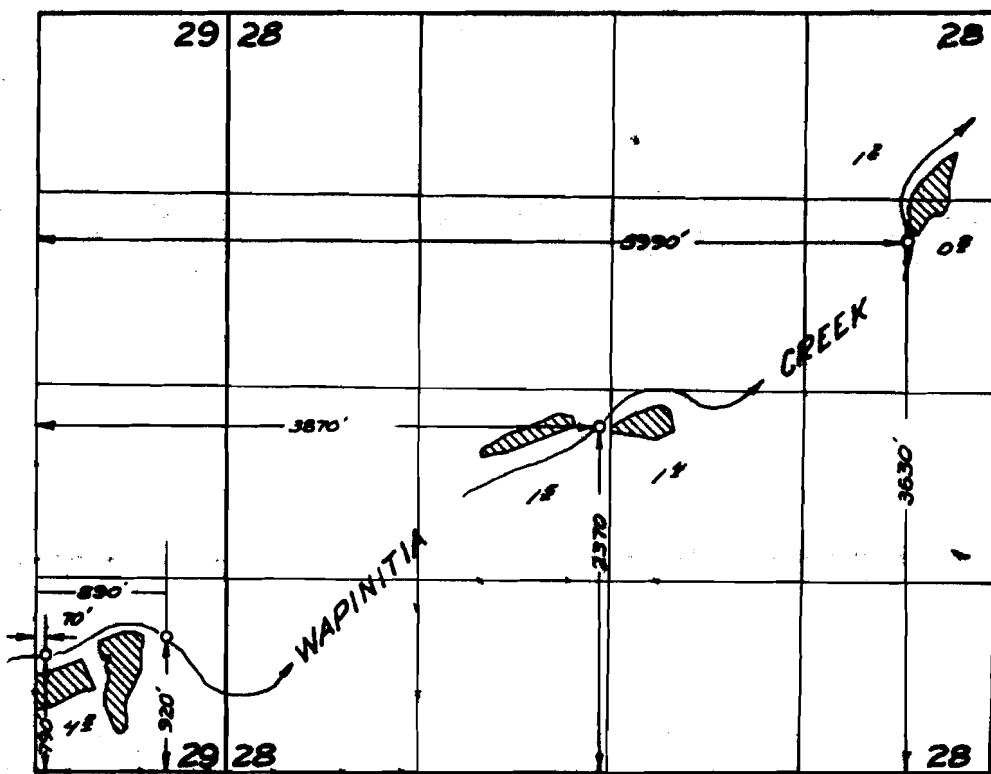

## FINAL PROOF SURVEY UNDER

Application No. 40216... Permit No. 29996

IN NAME OF

CLARENCE and DAVE DULING  
NATURAL PASTURE RANCH

Surveyed Apr. 2... 1967, by V. Garner