


R-4551
30284

T 3 S. R. 13 E. W. M.

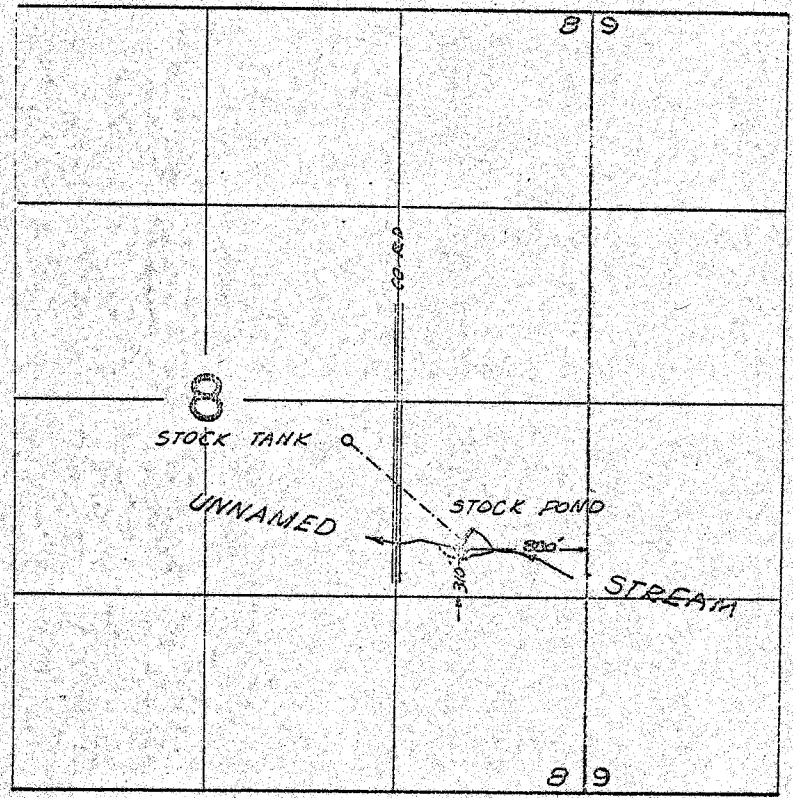

FINAL PROOF SURVEY UNDER

Application No. R-40551 40256 Permit No. R-4551 30284
IN NAME OF

JOHN HIX

Surveyed Nov. 16, 1967, by V. Garner