


R-4551
30284

T3S. R.13E. W.M.

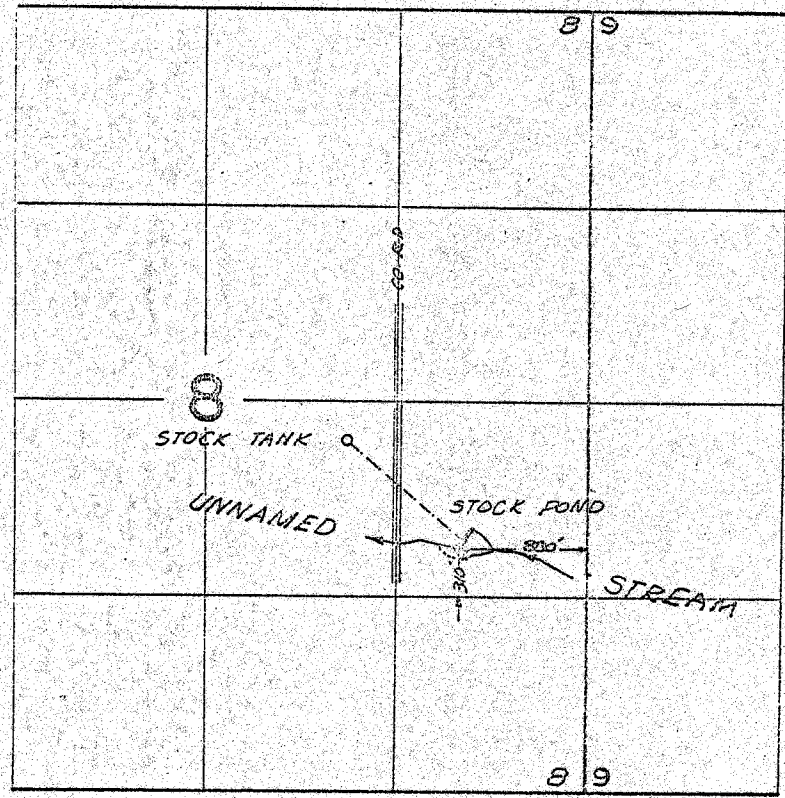

FINAL PROOF SURVEY UNDER

Application No. R-40551 Permit No. R-4551
IN NAME OF

JOHN HIX

Surveyed Nov. 16, 1967, by V. Garner