


T. I. S. R. I. W. W. M.

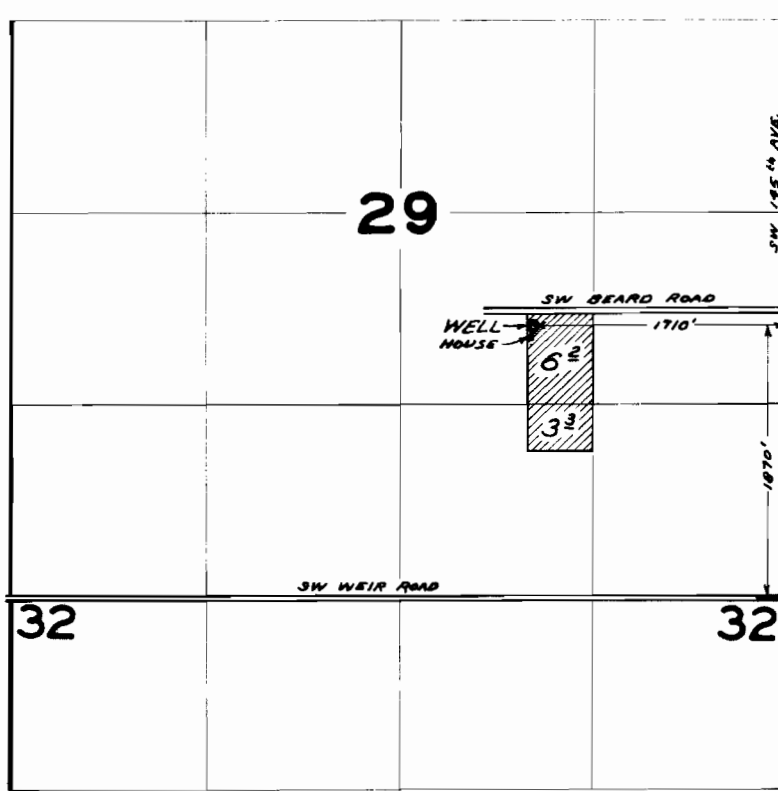

FINAL PROOF SURVEY UNDER

Application No. G-3865 Permit No. G-3441
IN NAME OF

MRS. CYRENE ELIZABETH HARDIE

Surveyed SEP 15 1967, by V. GARNER