


T. 1 S. R. 4 W. W. M.

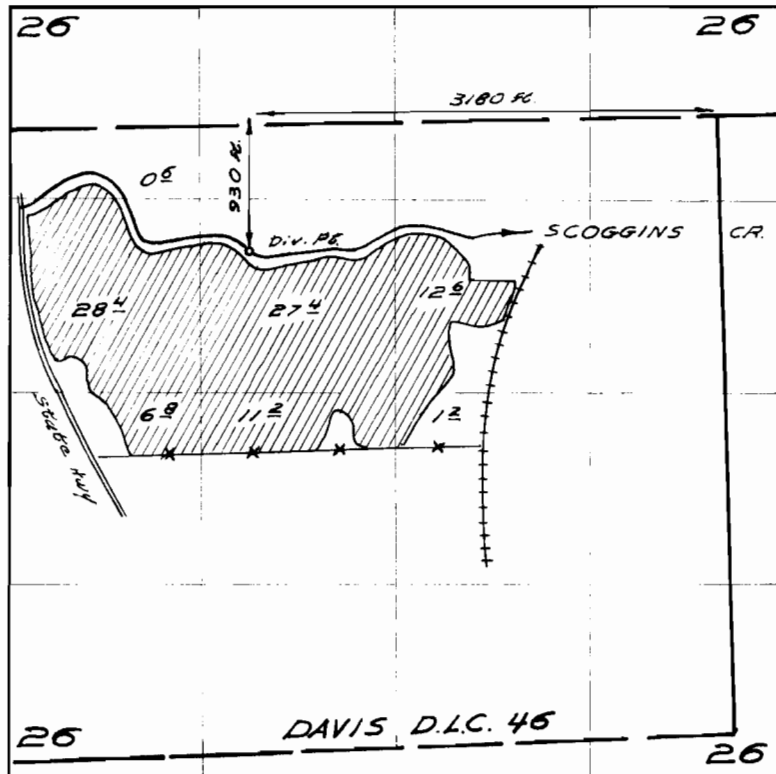

FINAL PROOF SURVEY
UNDER

Application No. 34725 Permit No. 27266
IN NAME OF

Alvin J. or Elaine C. Van Dyke

Surveyed Aug 22 1966, by W. J. Ruppert