


T.2N.R.2W.W.M.

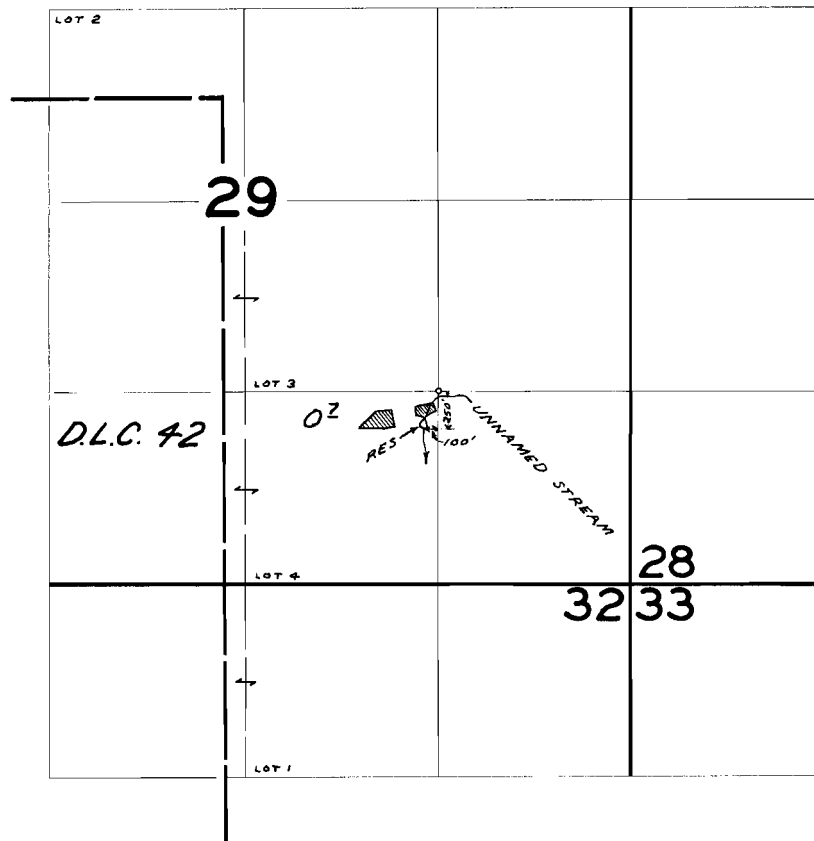

FINAL PROOF SURVEY
UNDER

Application No. 38711 Permit No. 28935
R-38847 R-3427
IN NAME OF

JACK W. LUSCHER

Surveyed JUN. 5 1967, by V. GARNER