


T. 4 S. R. 3 W. W.M.

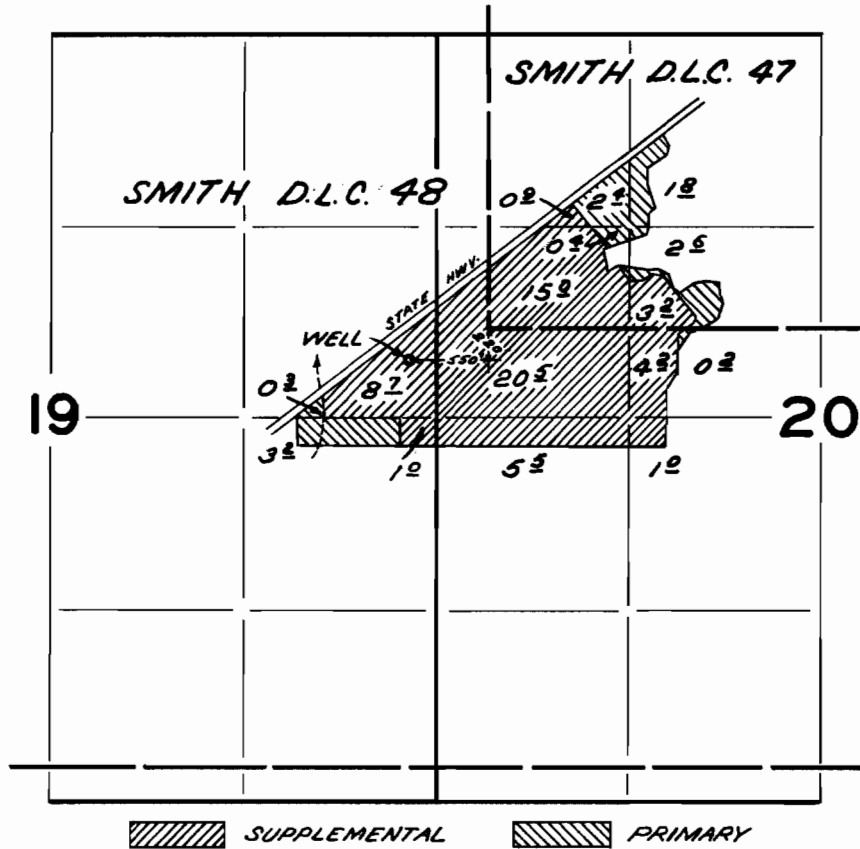

FINAL PROOF SURVEY
UNDER

Application No. G-3344 Permit No. G-3140
IN NAME OF

SAMUEL B. SWEENEY

Surveyed JUN. 2 1967, by V. GARNER