


T. 3 S. R. 6 W. W. M.

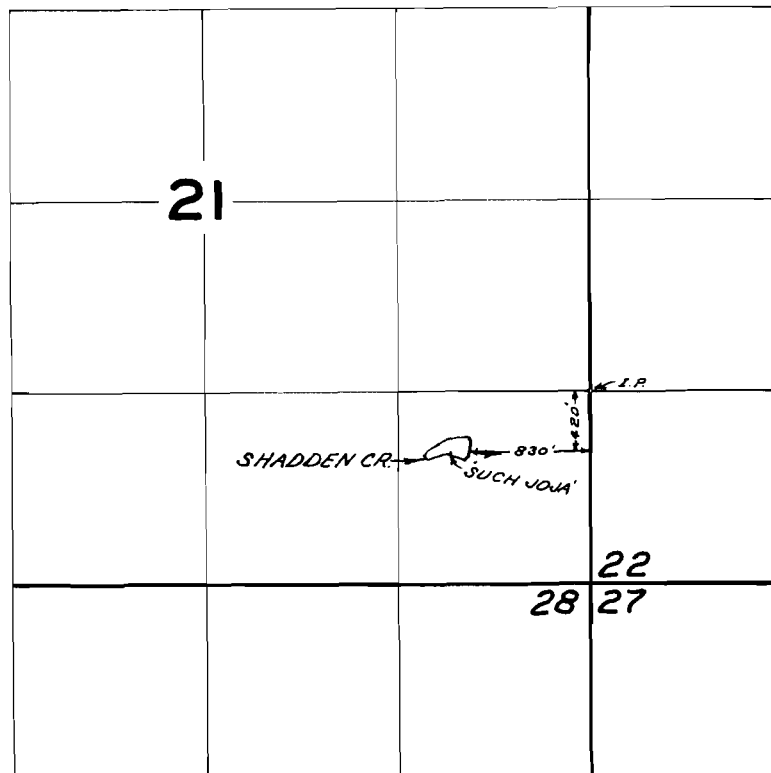

FINAL PROOF SURVEY
UNDER

Application No. R-37144 Permit No. R-2703
IN NAME OF

SHADDEN LUMBER COMPANY

Surveyed MAY 1 1967, by V. GARNER