


T. 3 S. R. 4 & 5 W. W. M.

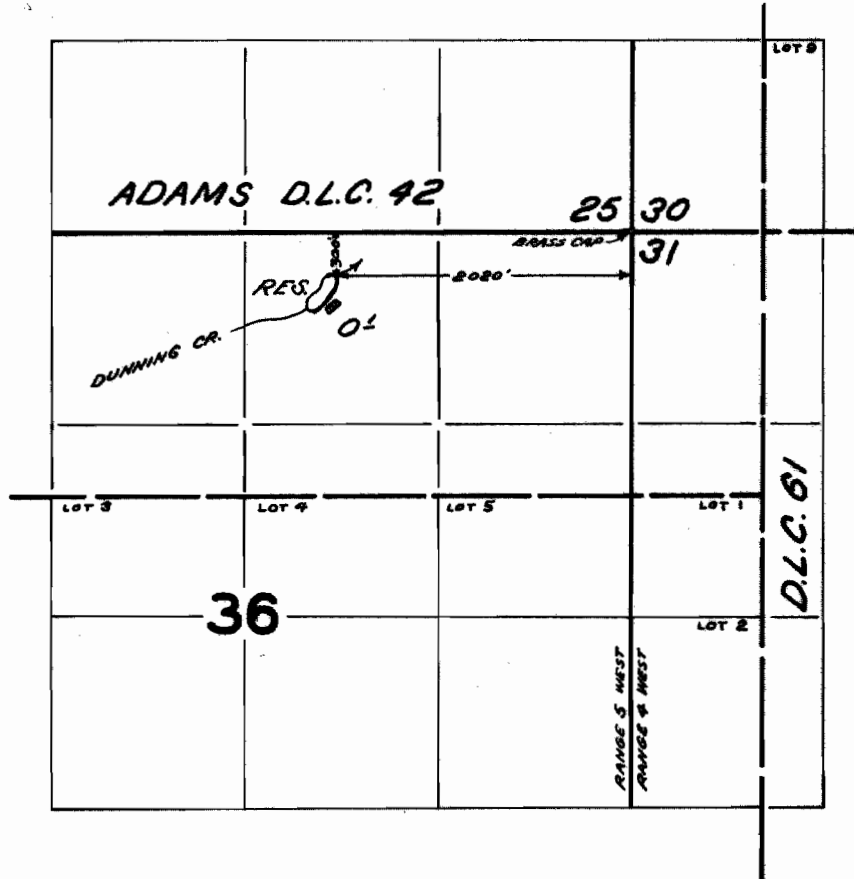

FINAL PROOF SURVEY UNDER

Application No. 34479 ~~R-34844~~ Permit No. 27316 ~~R-2614~~
IN NAME OF

ROBERT R. LUOTO

Surveyed MAY 7 1967, by V. GARNER