


T.5S.R.7 W.W.M.

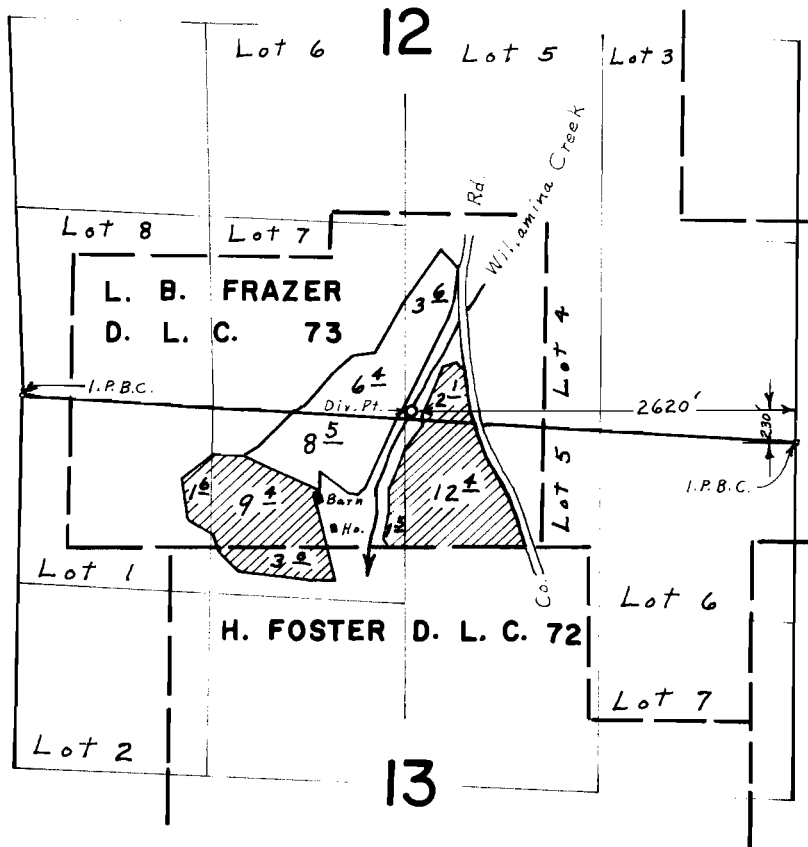


FINAL PROOF SURVEY UNDER

Application No. 37040 . Permit No. 27564.
IN NAME OF
LEWIE H. DURNIL

Surveyed June 1, 1967, by L. E. Gould .

T.5S.R.7 W.W.M.

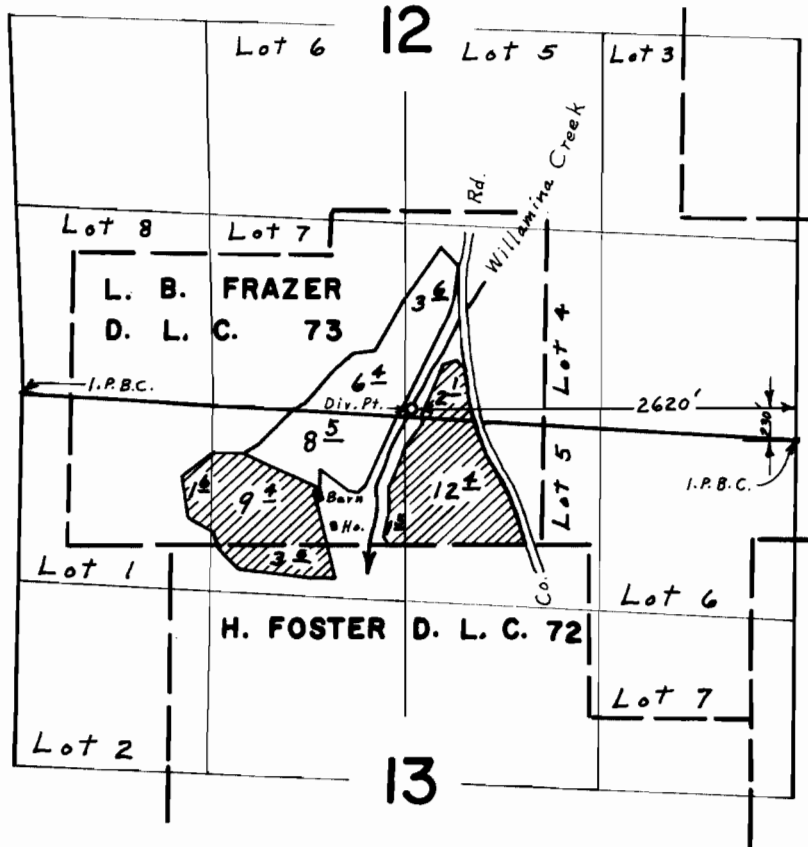

FINAL PROOF SURVEY UNDER

Application No. 37040 Permit No. 27564
IN NAME OF
LEWIE H. DURNIL

Surveyed June 1, 1967, by L. E. Gould