


# T.2S.R.4W.W.M.

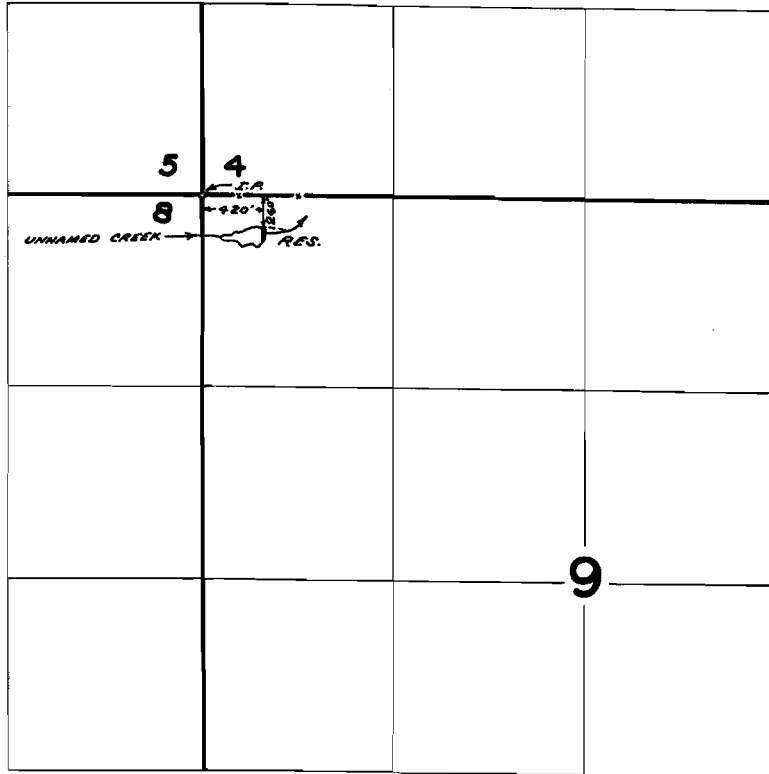

## FINAL PROOF SURVEY UNDER

Application No. R-39760 39958 Permit No. R-3975 29679  
IN NAME OF

NEIL W. RANKIN

Surveyed SEP 7 1967, by V. GARNER