


T.4S. R.3W. W.M.

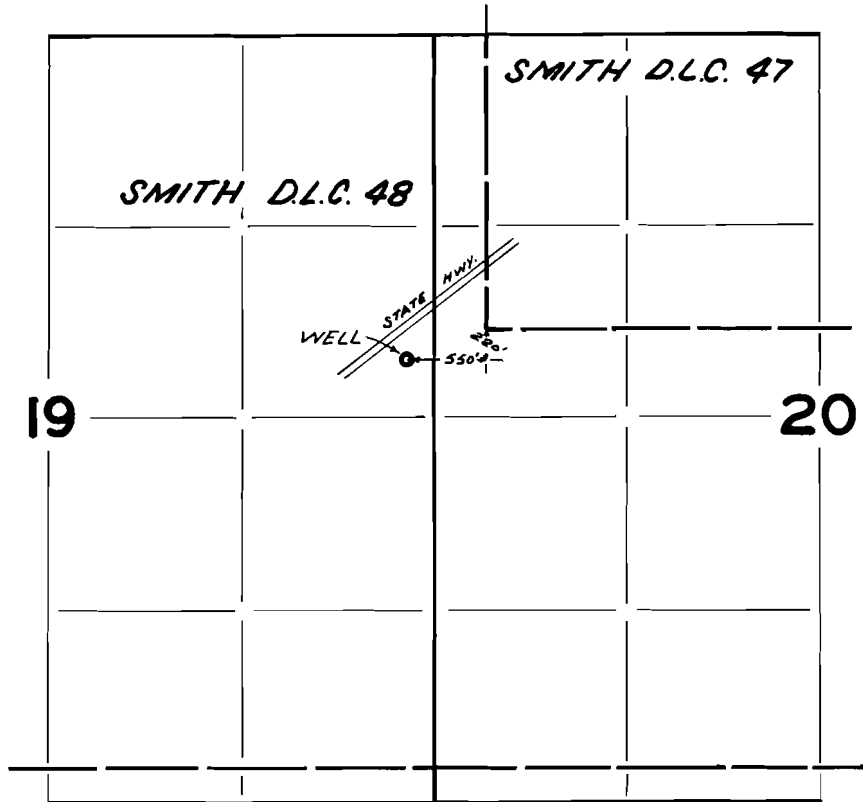


FINAL PROOF SURVEY
UNDER

TRANSFER No. S-179
Application No. Permit No.
IN NAME OF

SAMUEL B. SWEENEY

Surveyed JUN. 2 1967, by V. GARNER

T.4 S.R.3 W.W.M.

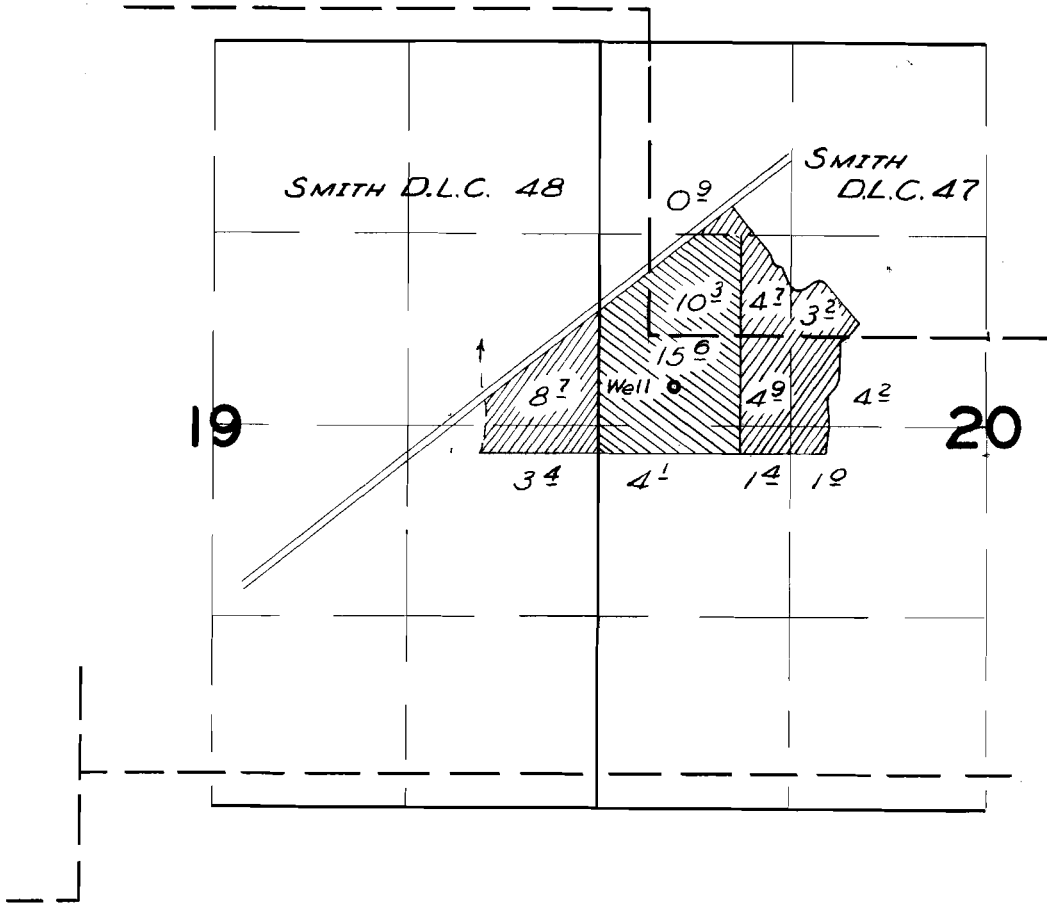

FINAL PROOF SURVEY UNDER

Application No. G-132 Permit No. G-62
IN NAME OF

PHILLIPS B. SWEENEY

Surveyed 24 MAY 1960, by Mr. Bish