


**T.15S. R.5 W.W.M.**

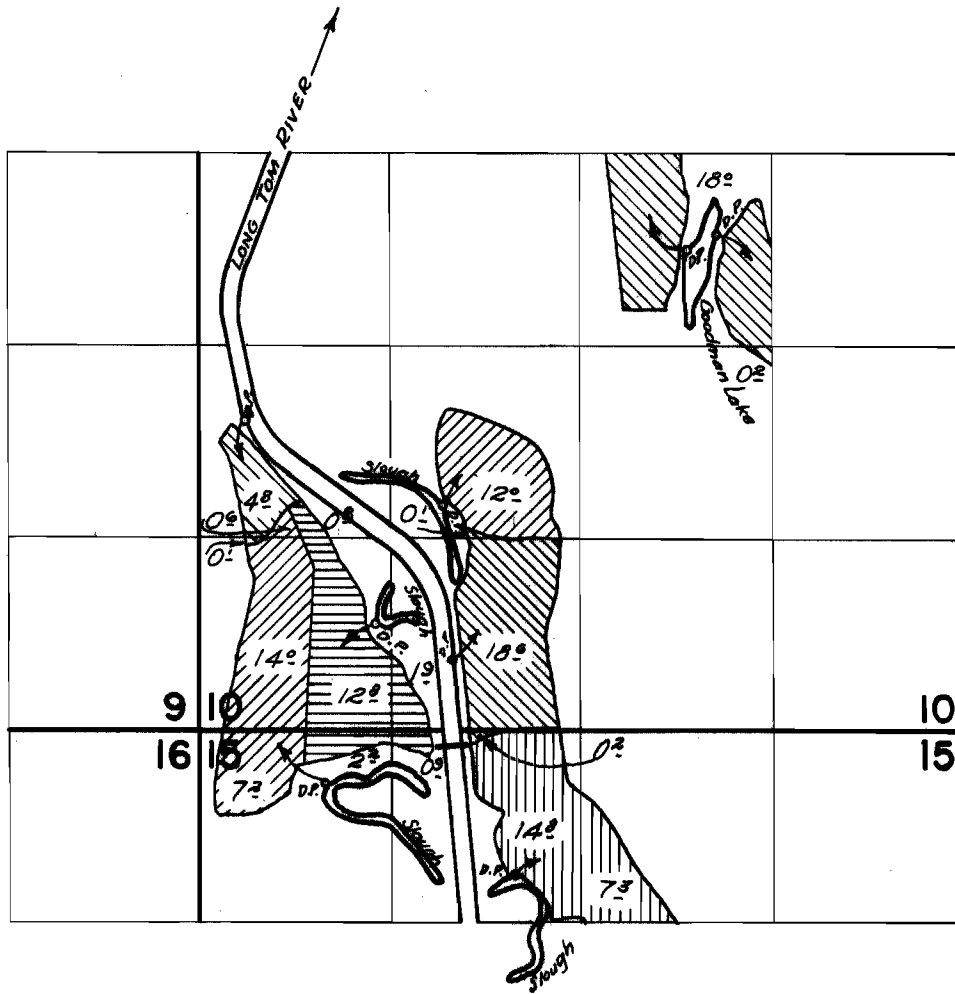

# FINAL PROOF SURVEY

## UNDER

Application No. **33104**.... Permit No. **26726**...  
IN NAME OF

**ROBERT STRODA**

Surveyed May 12, 1961, by St Jackson