


T.4S.R.1E.W.M.

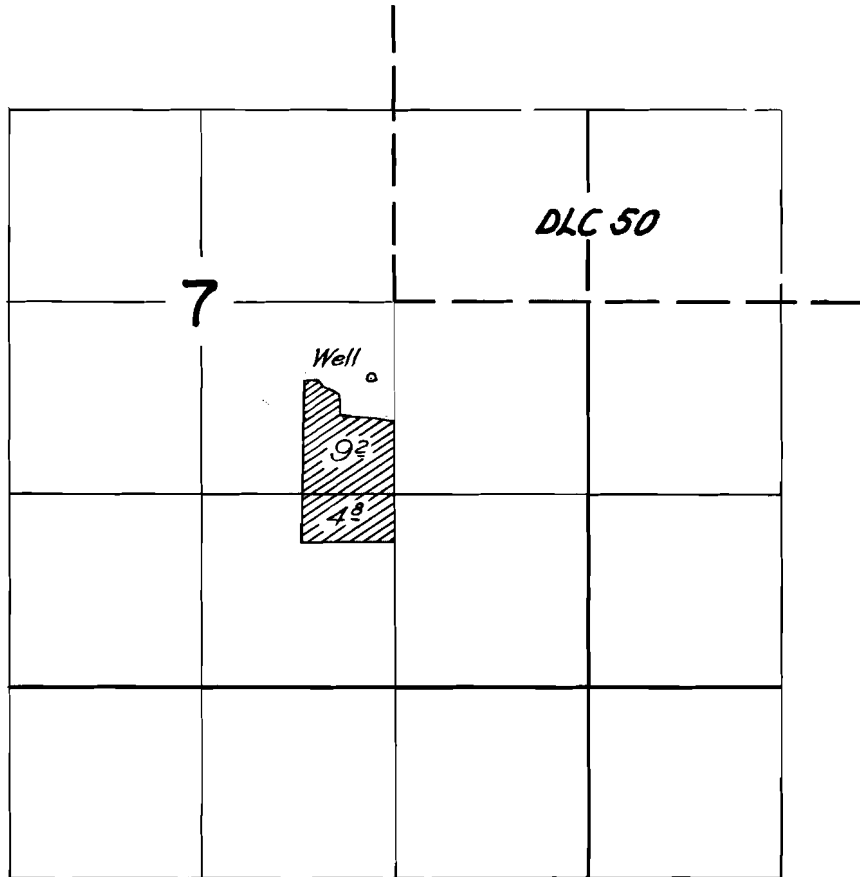

FINAL PROOF SURVEY UNDER

Application No. *G-1975* Permit No. *G-1811*
IN NAME OF

Joseph N. Hershberger

Surveyed *June 22* 1962, by *Thomas F. Lauer*