


T. 1 S. R. 3 W. W. M.

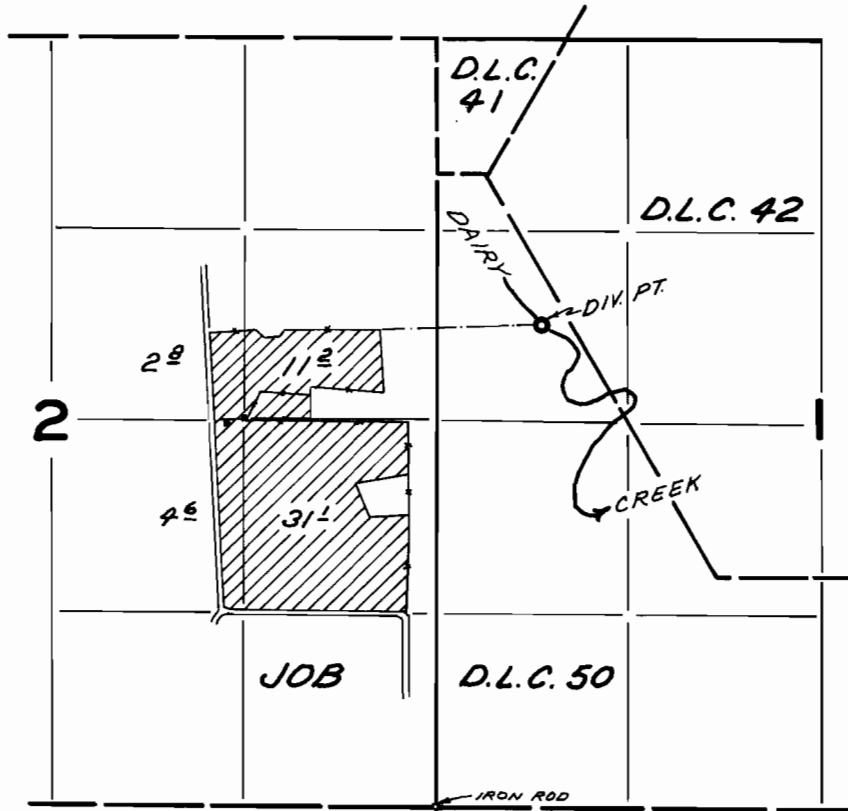

**FINAL PROOF SURVEY**  
UNDER

Application No. 29775 Permit No. 23505  
IN NAME OF

GERALD VAN DYKE

Surveyed MAY 29 1959, by R. JACKSON