


T.7 & 8S. R.46E. W.M.

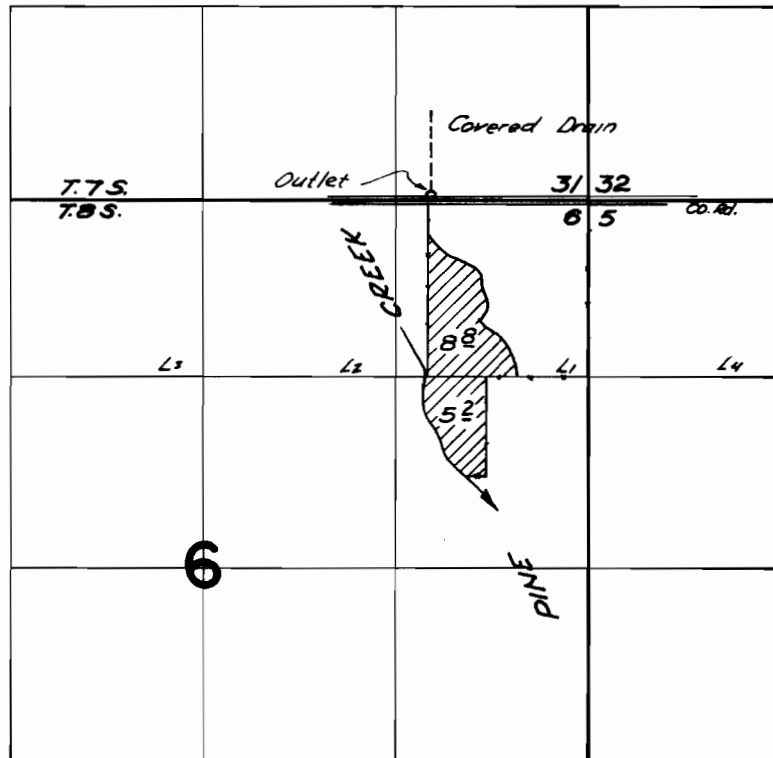

Drain located 30 ft. N and 1080 ft. W to a point 620 ft. N. & 1080 ft. W. from the S.E. Corner Section 31

FINAL PROOF SURVEY UNDER

Application No. G-3256 Permit No. G-3055
IN NAME OF

..... FLOYD BOWERMAN

Surveyed July 29, 1967, by V. Garner