


T.9S. R.39E. W.M.

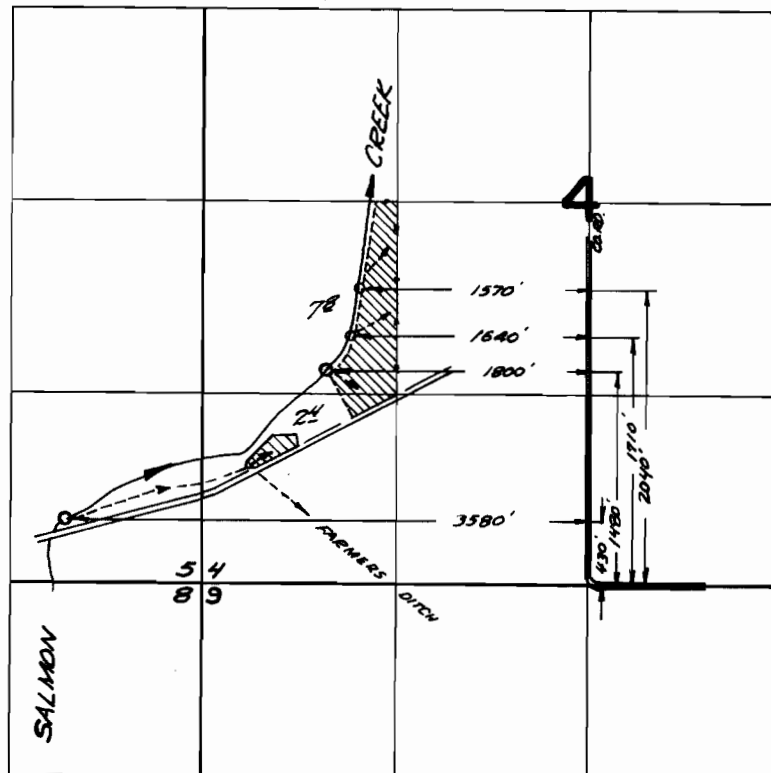

FINAL PROOF SURVEY
UNDER

Application No. 34616 Permit No. 27199
IN NAME OF

ALVIN FRANK LITTLE

Surveyed Oct. 24 1967, by V. Garner