


T.8S. R.38 E. W.M.

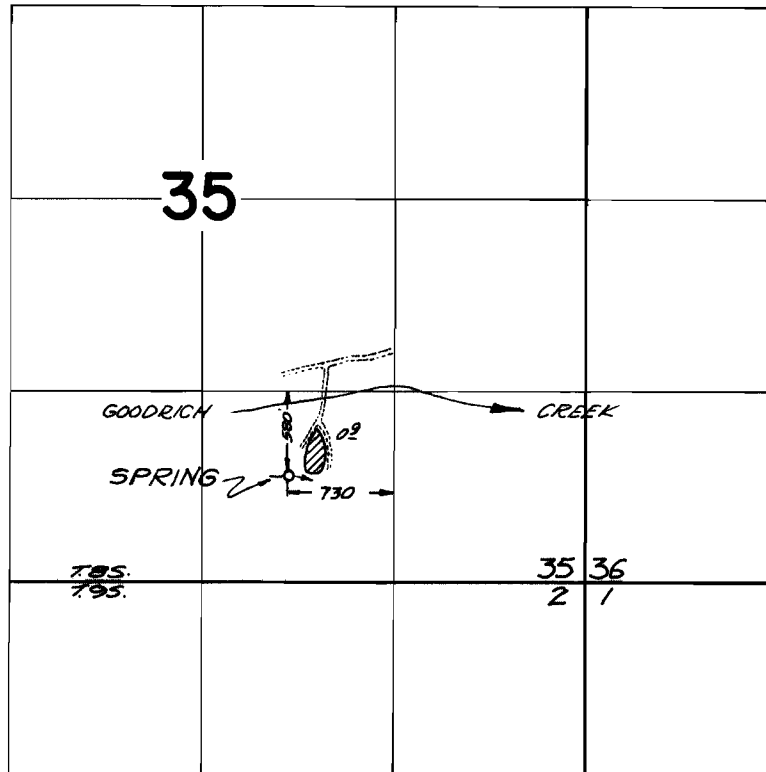

FINAL PROOF SURVEY
UNDER

Application No. 37849 Permit No. 28425
IN NAME OF

ROBERT W. POLLOCK MD.

Surveyed Oct. 25 1967, by V. Garner