


T.8 S. R.39 E. W.M.

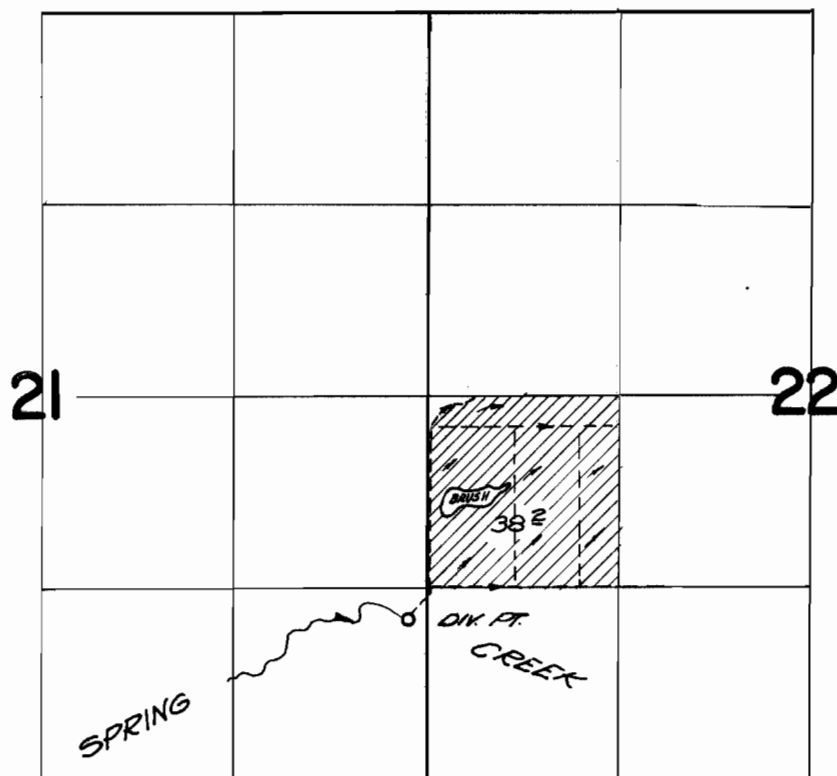

*Div pt. located 1530 ft. S. and 130 ft. W.
from the W $\frac{1}{4}$ cor. section 22*

**FINAL PROOF SURVEY
UNDER**

Application No. 38742 Permit No. 28836
IN NAME OF

CHARLES M. CHINN, JR.

Surveyed Oct. 22, 1967, by V. Garner