


T.9S. R.39E. W.M.

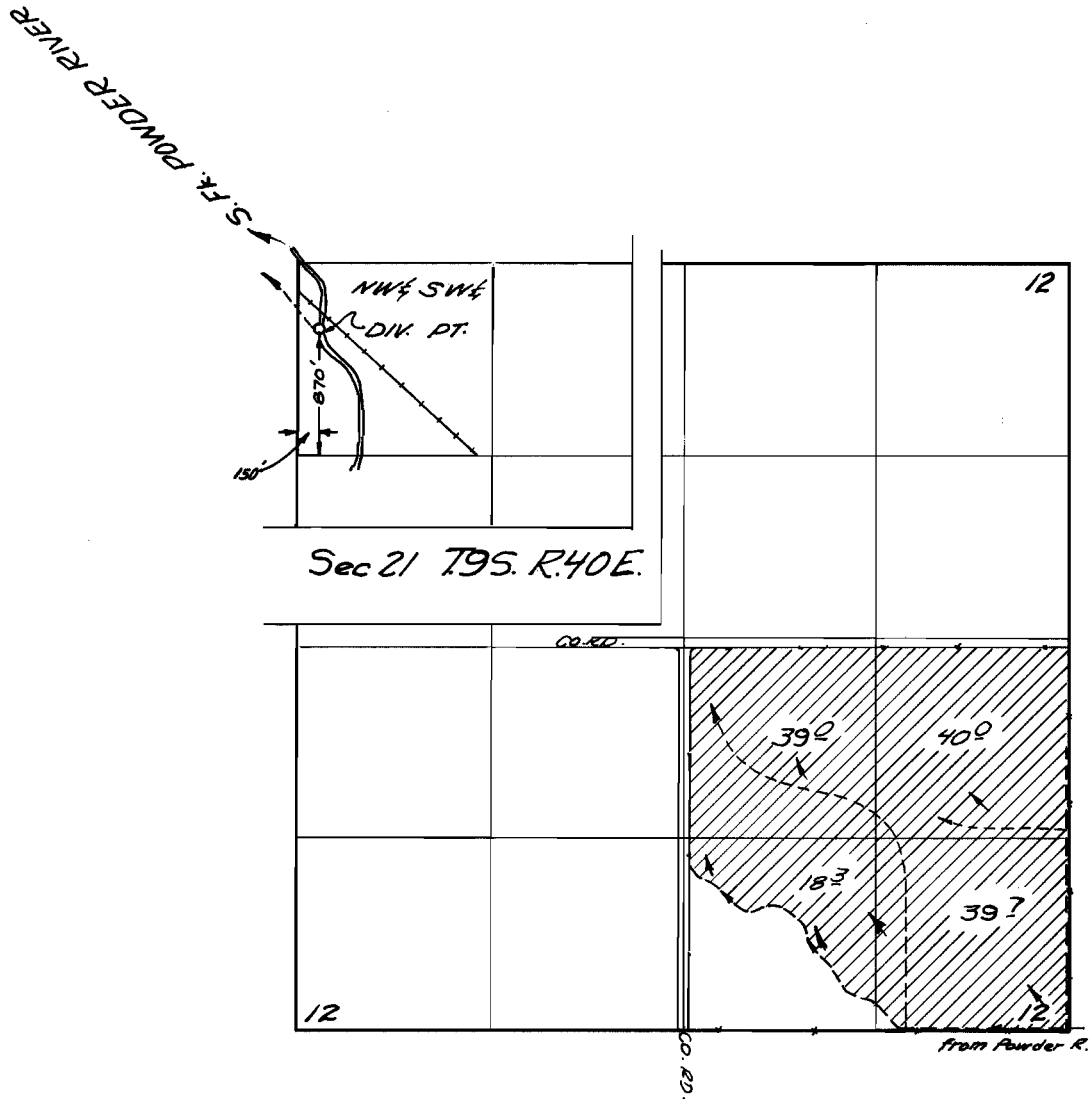

FINAL PROOF SURVEY
UNDER

Application No. 40956 Permit No. 30544
IN NAME OF

EDYTHE McELROY and ALENE BROWN

Surveyed July 26, 1967, by V. Garner