


T.6N.R.2W.W.M.

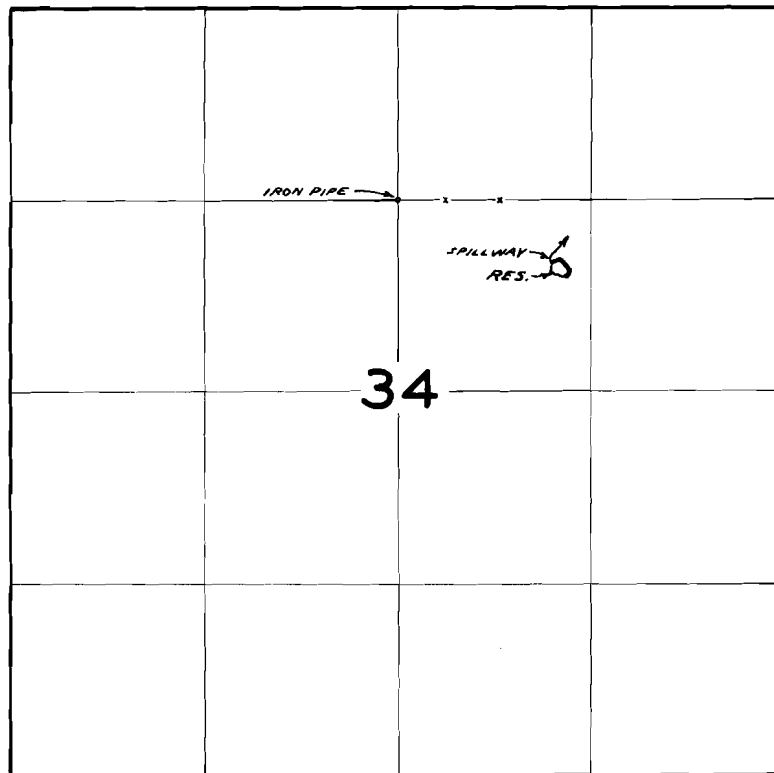

FINAL PROOF SURVEY
UNDER

Application No. R-39213 Permit No. R-3880
IN NAME OF

BURL ADAMS

Surveyed JUL 19 1967, by V. GARNER