


T. 7 N. R. 5 W. W.M.

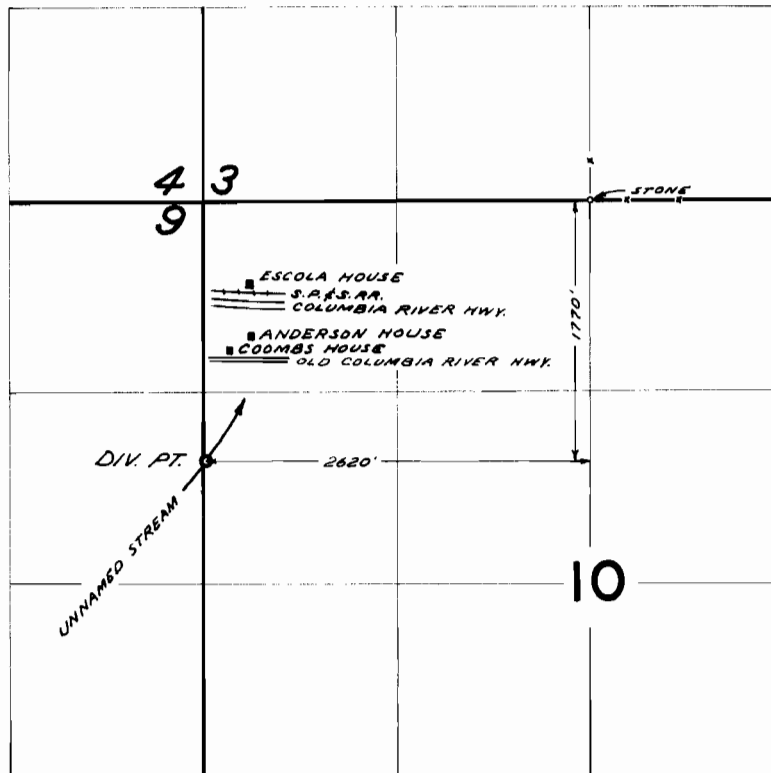

FINAL PROOF SURVEY
UNDER

Application No. *41087* Permit No. *30607*
IN NAME OF
PHILLIP D. COOMBS (ACTING FOR)
ELIAS J. COOMBS, E.R. ESCOLA, CARL I. ANDERSON

Surveyed *AUG. 16* 1967, by *V. GARNER*