


T.23S. R.9&10 W. W.M.

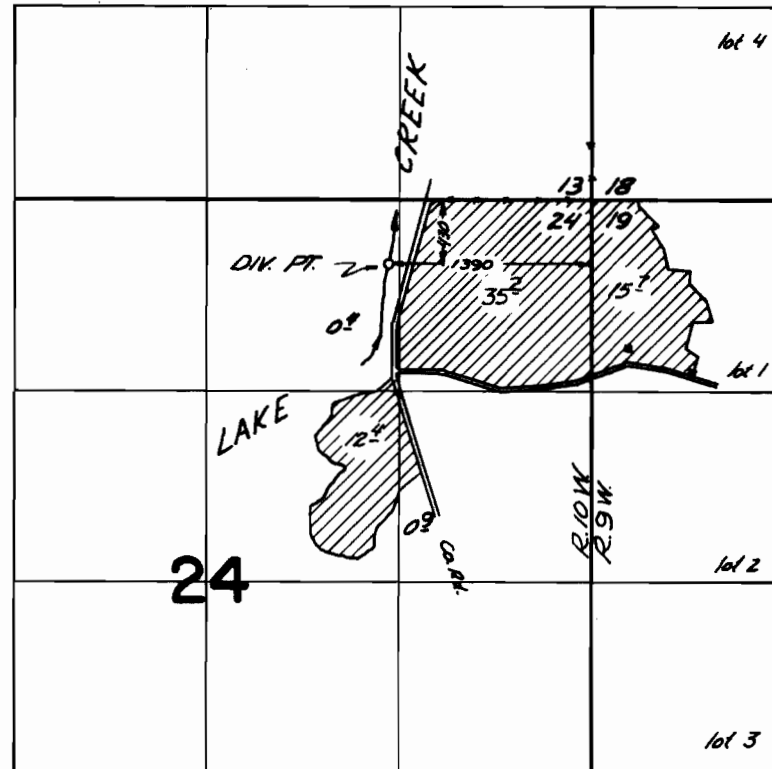

FINAL PROOF SURVEY
UNDER

Application No. 33947 Permit No. 26761
IN NAME OF

J.H. PARKER

Surveyed July 11 1967, by V. Garner