


# T.25S. R.6W. W.M.

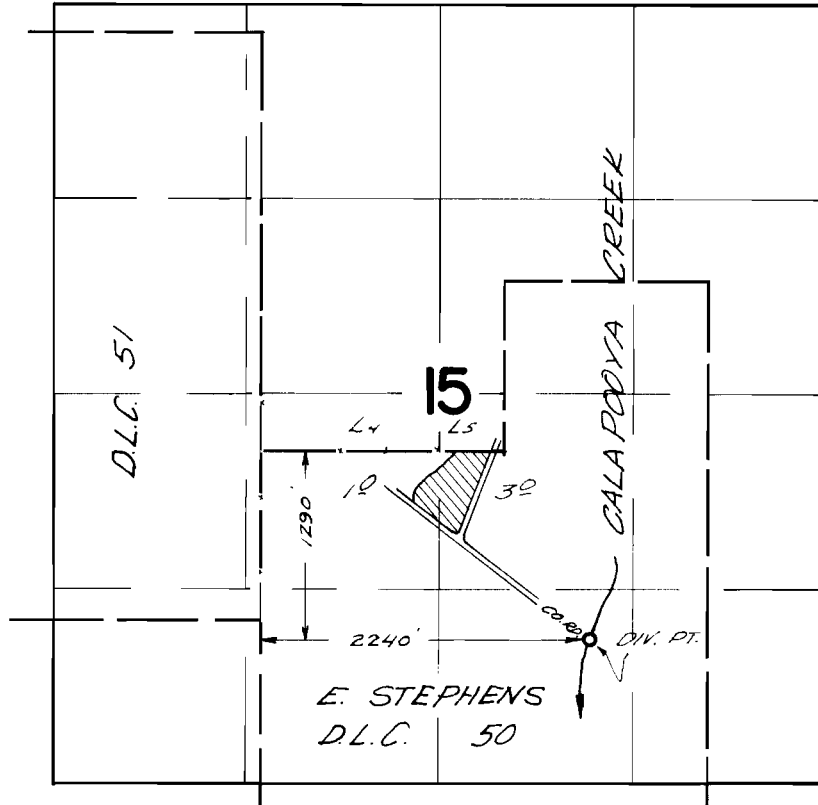

## FINAL PROOF SURVEY UNDER

Application No. 37070 Permit No. 27579  
IN NAME OF

*MARY K. FORSTER*

Surveyed *April 27 19.67*, by *V. Garner*