


T.28S. R.6W. W.M.

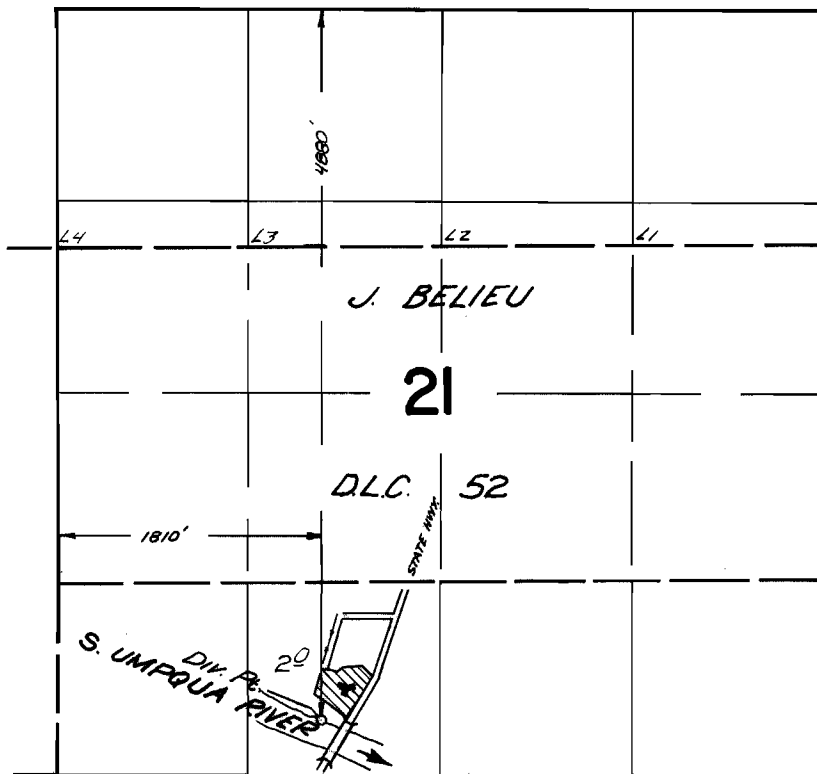

FINAL PROOF SURVEY UNDER

Application No. 37932 Permit No. 28247
IN NAME OF

DR. M.L. and ETHEL E. FLETCHER

Surveyed April 20, 1967, by V. Garner