


T.22S. R.7W. W.M.

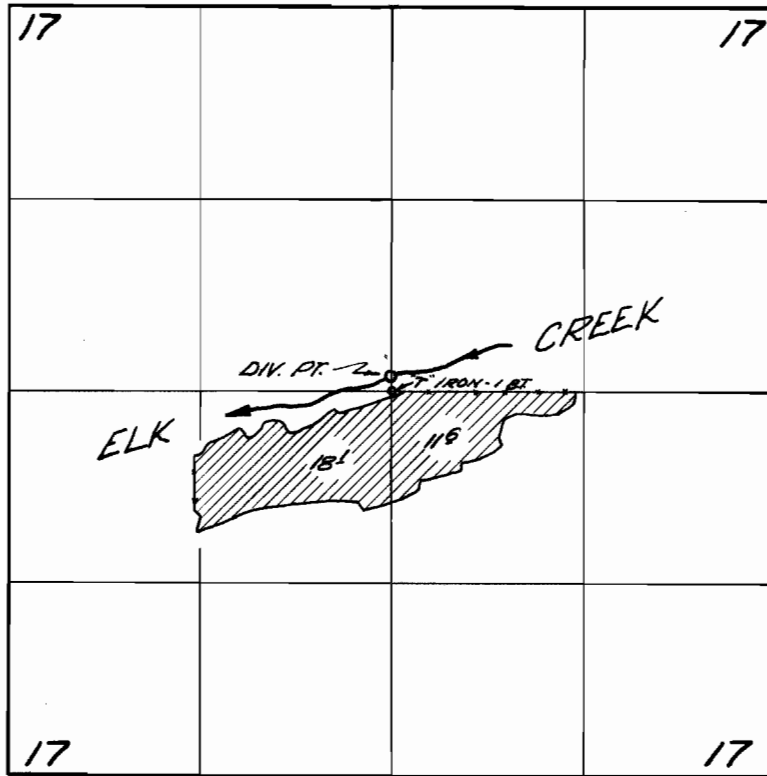

*Div. pt. located 100 feet N. and 5 feet W.
from the center of section 17*

FINAL PROOF SURVEY UNDER

Application No. 39818 Permit No. 29591
IN NAME OF
ELMER SCHAD, VENNIE SCHAD,
WARREN E. SCHAD and FREDERICA SCHAD

Surveyed July 11 1967, by V. Garner