


# T.40S. R.8W. W.M.

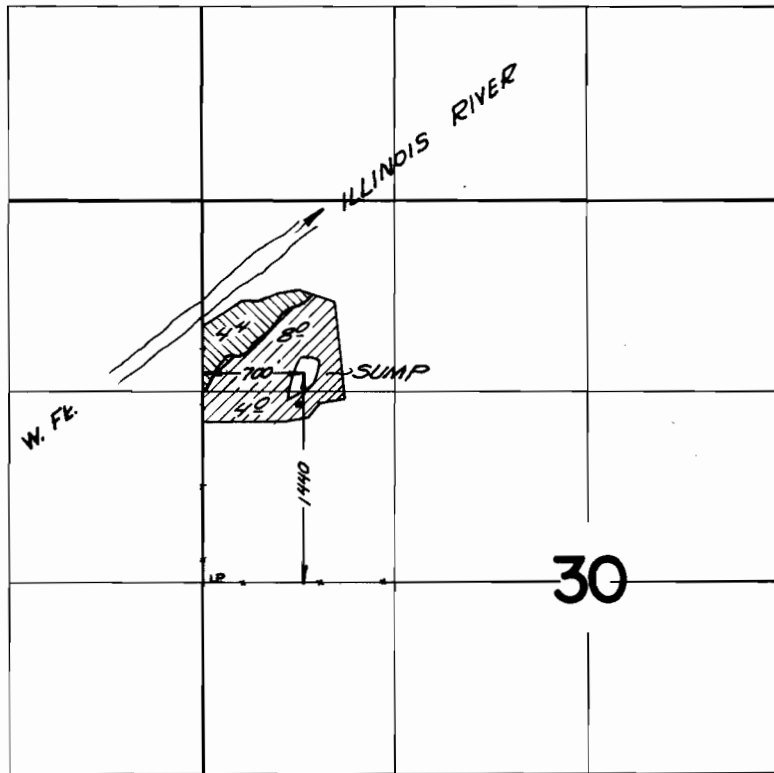

 PRIMARY  SUPPLEMENTAL

## FINAL PROOF SURVEY UNDER

Application No. G-3242. Permit No. G-3045.  
IN NAME OF

.....*C.E. ROSS*.....

Surveyed *May 17, 1967*, by *V. Garner*.....